



T.33 S., R.2 E., W.M.

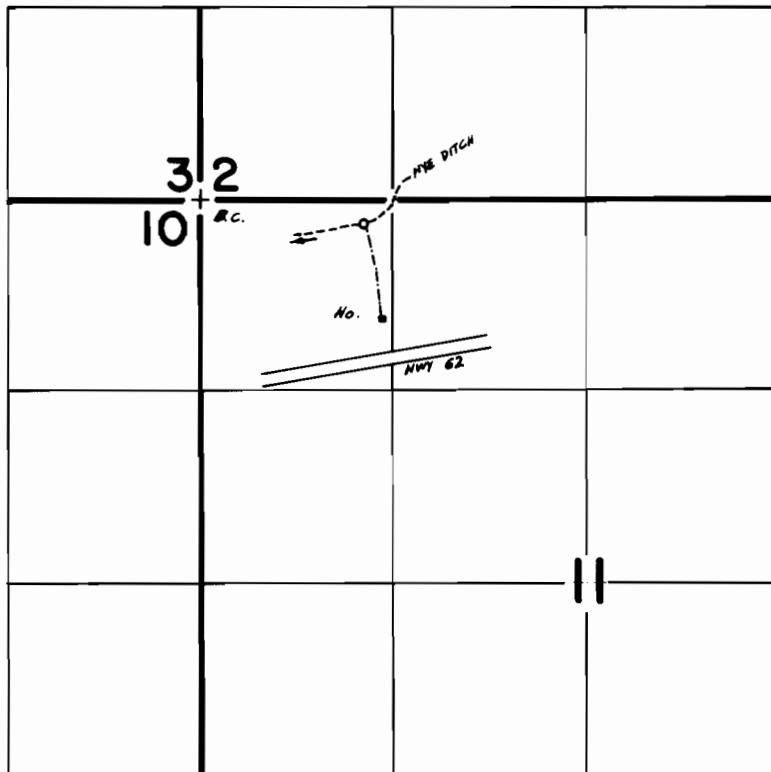

T.32 S., R.3 E., W.M.

SCALE 1"=1320'

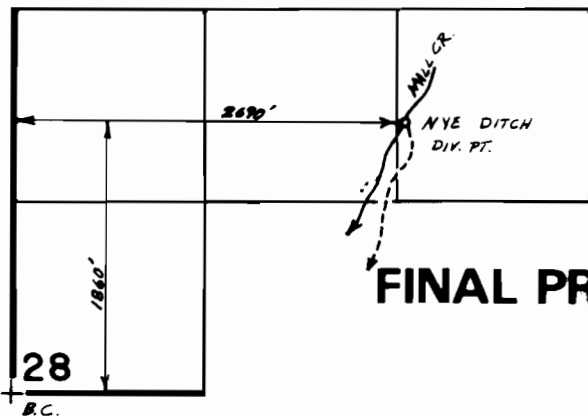

FINAL PROOF SURVEY
UNDER

Application No. **58568** Permit No. **44171**.....
IN NAME OF

ROBERT BURNS

Surveyed **May 24, 1983**, by **B.S. JAMES**.....