


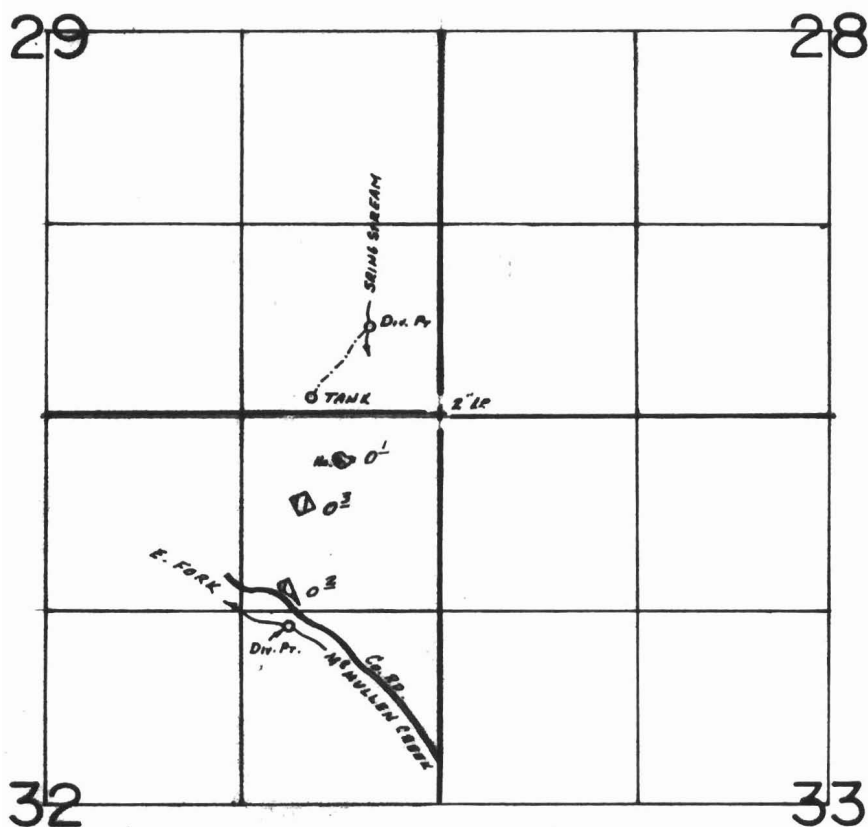

SCALE: 1" = 1320'

FINAL PROOF SURVEY

UNDER

Application No. **56257** Permit No. **42544**
59378 **44633**
 IN NAME OF

EUGENE V. VOGEL

Surveyed Nov. 6..... 1984, by J.R.WOODROOF..