T. 37 S., R. 6 W., W. M.

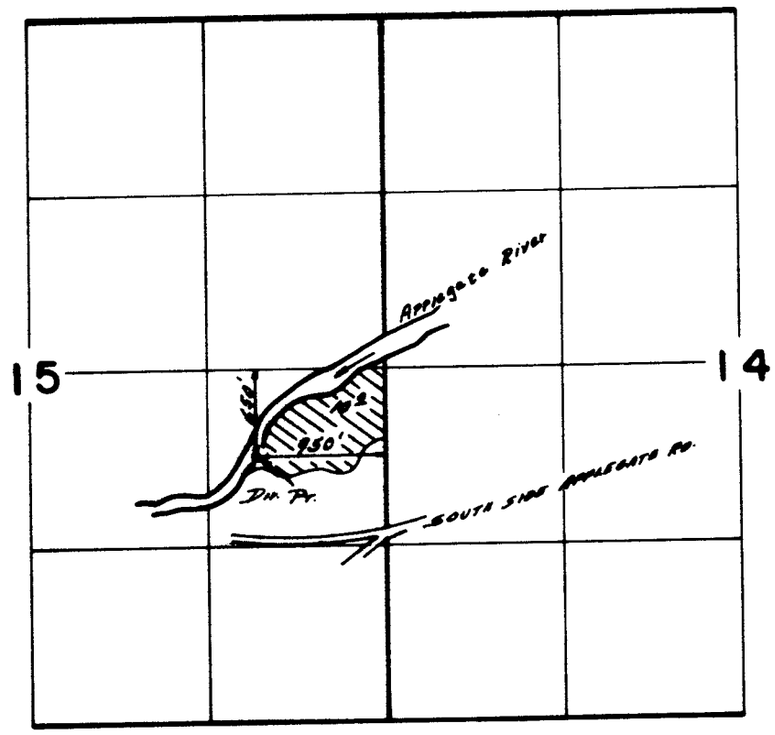

N

JUN 8 1988

WM. DIST. 14
GRANTS PASS, ORE.

Scale: 1" = 1320'

FINAL PROOF SURVEY
UNDER

Application No. 61922 Permit No. 45890
IN NAME OF

INEZ, SCOTT, & BARBARA HASSETT

Surveyed JUL. 29 1986, by B. S. JAMES

B-50-2-6