


T. 38 S., R. 7 W., W. M.

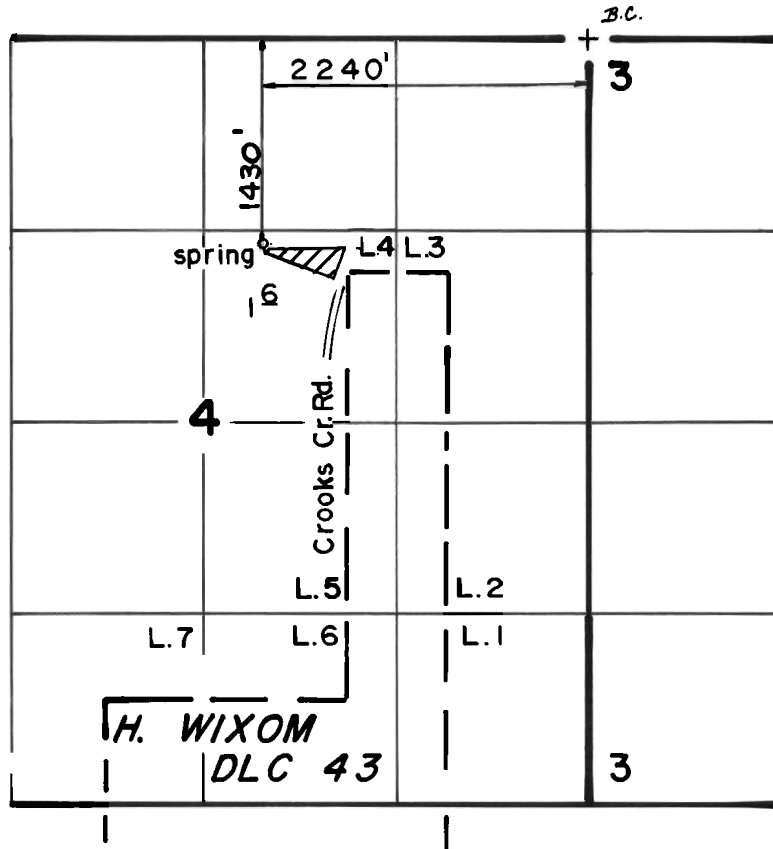

Scale: 1" = 1320'

FINAL PROOF SURVEY
UNDER

Application No. 60075 Permit No. 46005
IN NAME OF

.....LEWIS A. MOREY.....

Surveyed JUN. 19 1986., by B. S. JAMES..