


Application No. 68381
Permit No. 49486

RECEIVED
JUN 10 1985
WATER RESOURCES DEPT
SALEM, OREGON

T 37 S R 6 W W.M.
SCALE 4" = 1 MILE

RECEIVED
AUG 30 1985
WATER RESOURCES DEPT
SALEM, OREGON

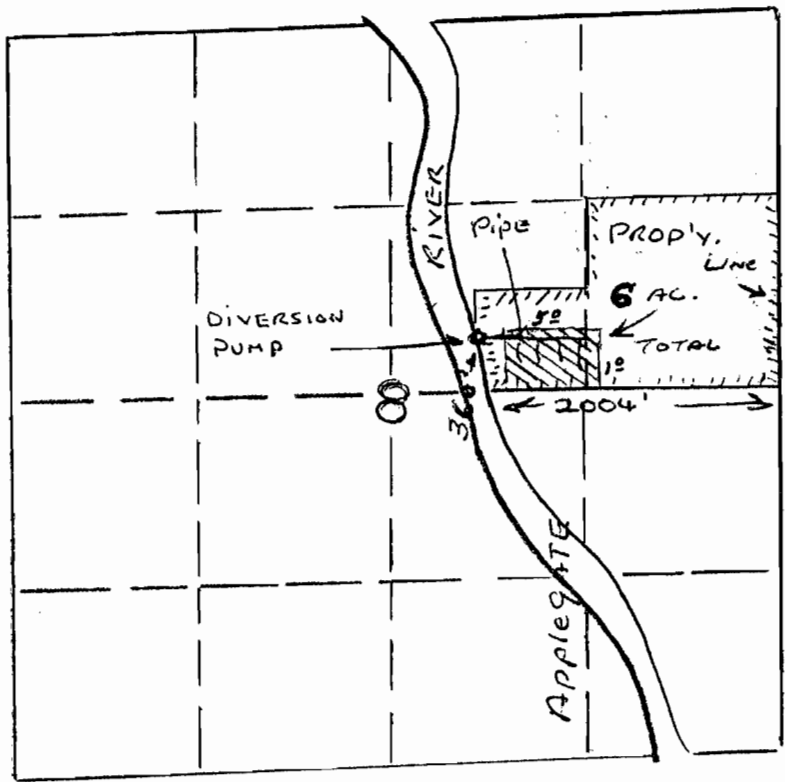

5 ACRES in 37 S 6 W 8 SW 1/4 NE 1/4
1 Acre in 37 S 6 W 8 SE 1/4 NE 1/4