


T. 27S., R. 6W., W.M.
SEC. 13

RECEIVED
MAY 14 1985

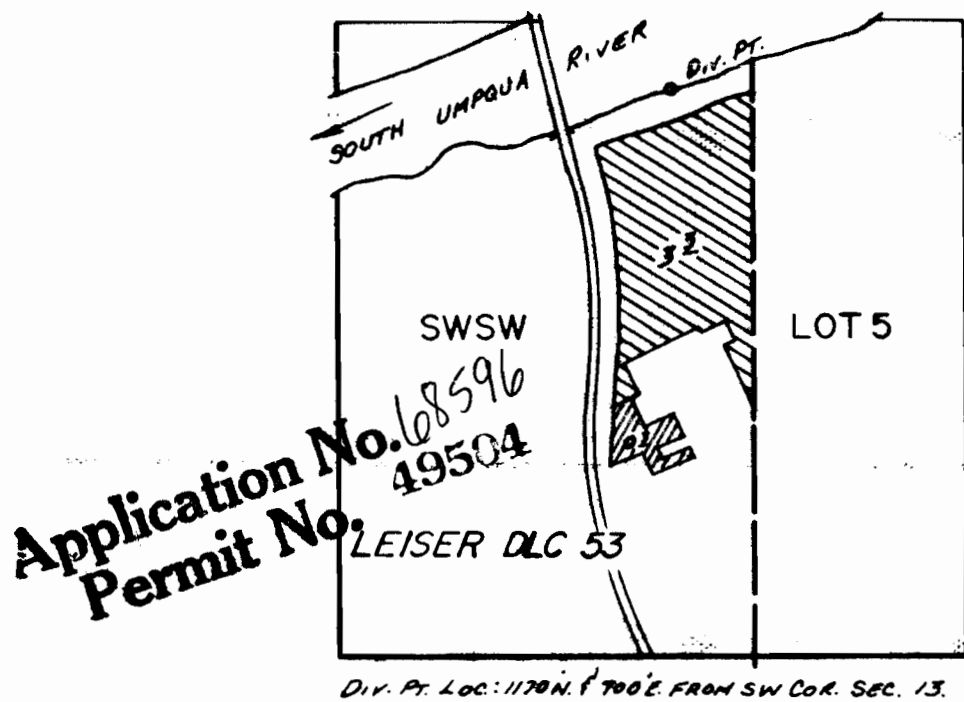

SCALE: 1" = 400'

FINAL PROOF SURVEY
UNDER

New Appl' - 
Application No. 57701... Permit No. 43481... 
IN NAME OF

Douglas County School District No. 4 (FIR GROVE)

Surveyed MAR. 27. 1980., by J.S. DONALDSON