


T.6S.R.1E.W.M.

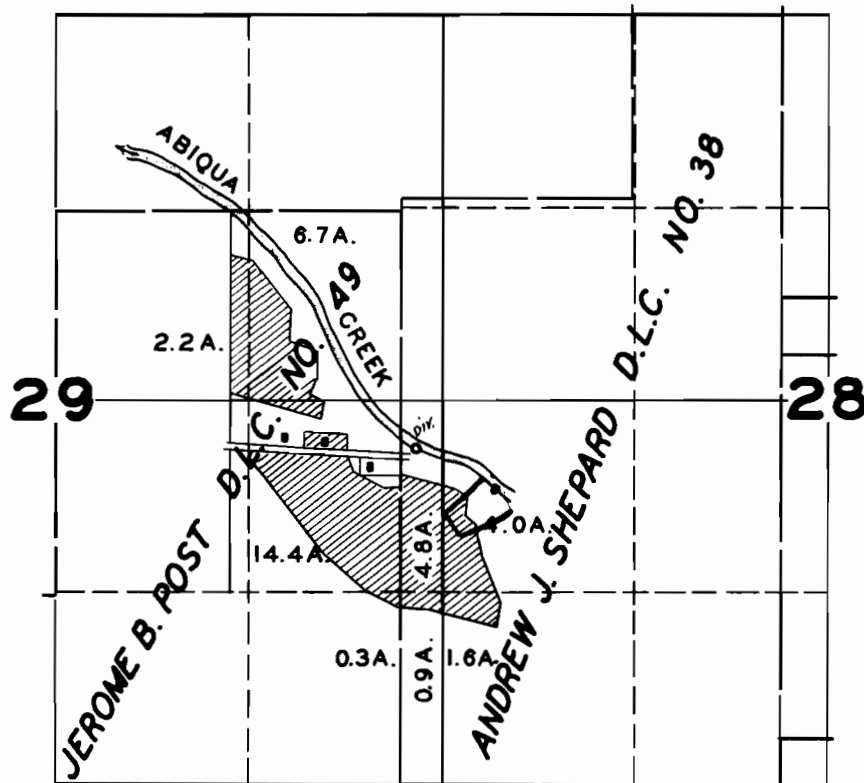

FINAL PROOF SURVEY UNDER

Application No. 16585 ... Permit No. 12647 ...
IN NAME OF

MURRAY WINSTEAD

Surveyed APR. 18, 1949, by JAS. E. BUNNELL