


T.6&7S.,R.21&22E.,W.M.

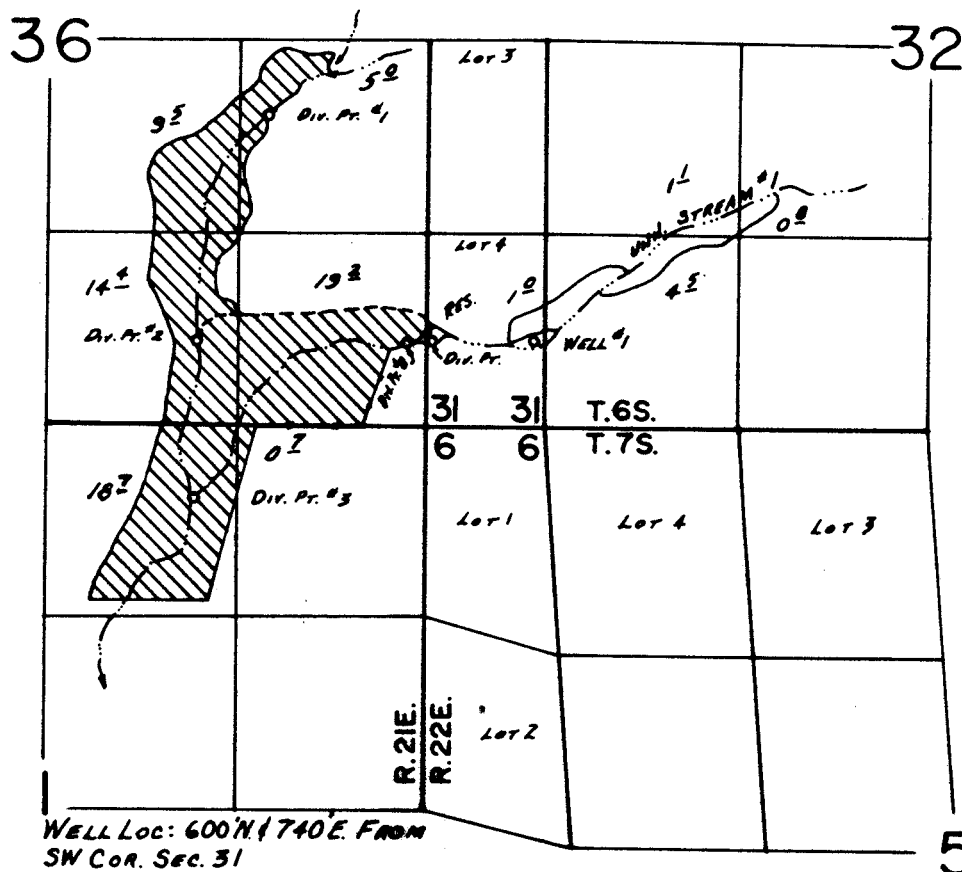

FINAL PROOF SURVEY UNDER

Application No. G-6844 Permit No. G-6388
IN NAME OF

ALVA HUNT

Surveyed JUNE 25, 1980, by S.C. BROWN