


57211
P-33652
R-5322
57210

T.6&7S.,R.21&22E.,W.M.

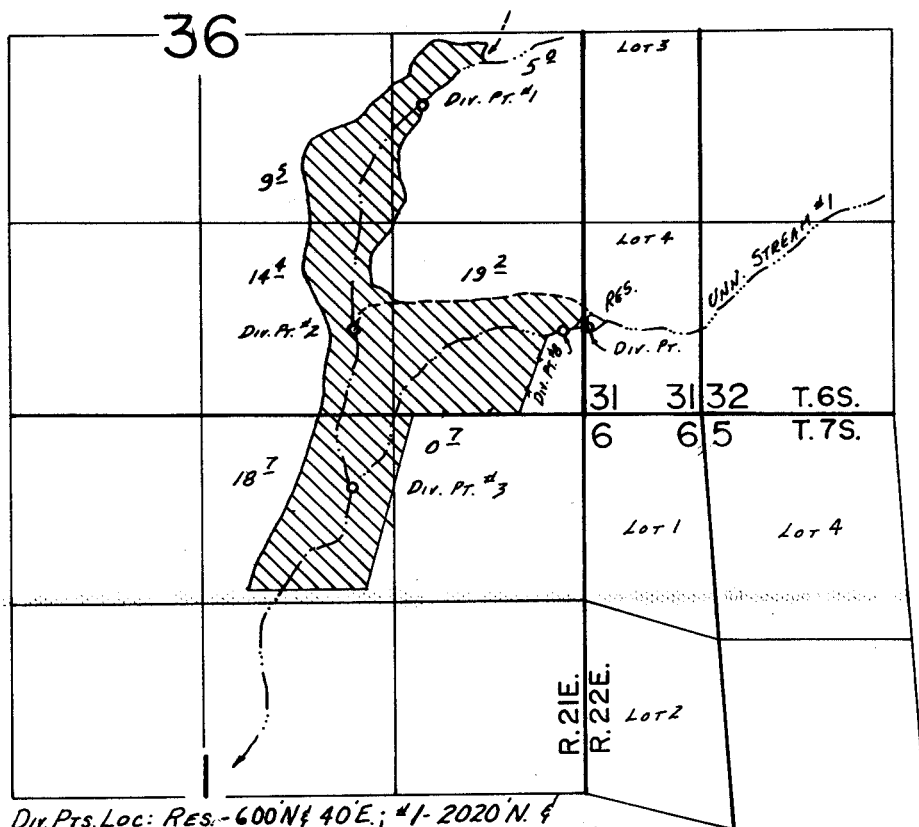

Div. Pts. Loc: Res. - 600' N. & 40' E.; #1 - 2020' N. & 1110' W.; #2 - 570' N. & 1580' W.; #3 - 500' S. & 1600' W.; #8 - 560' N. & 140' W.; ALL FROM SE COR. SEC. 36

FINAL PROOF SURVEY UNDER

R-45149 R-5322
Application No. 45024 Permit No. 33652.....
IN NAME OF

ALVA HUNT

Surveyed JUNE 25, 1980, by S.C. BROWN.....