


P-39927

57212

T.7S.,R.2E.,W.M.

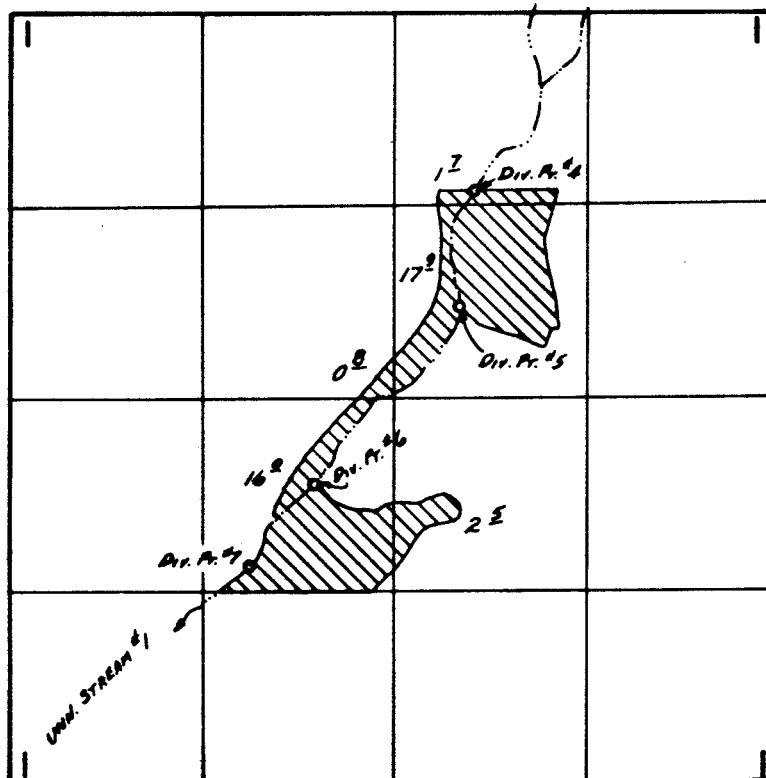

Div. Prs. Loc: "4-1230'S. / 2000'W.; "5-2010'S. / 2170'W.; "6-3230'S. / 3170'W.; "7-3790'S. / 3610'W.; ALL FROM NE COR. SEC. 1.

FINAL PROOF SURVEY **UNDER**

Application No. 53579... Permit No. 39927.....
IN NAME OF

ALVA HUNT

Surveyed JUNE 27... 1980... by S.C. BROWN.....