


T.4S.,R.1&2W.,W.M.

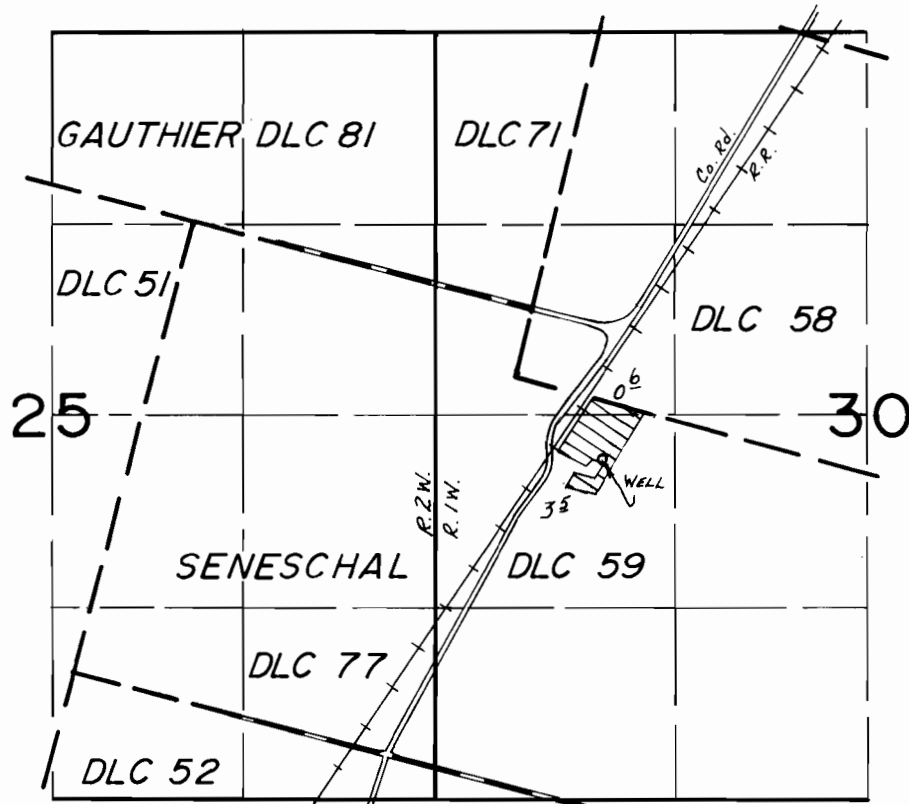

WELL LOC: 1040 S. & 470 E. FROM SE COR. GAUTHIER DLC 71

FINAL PROOF SURVEY

UNDER

Application No. G-6942. Permit No. G-6457.....
IN NAME OF

..... A. & M. C. PALACIOS

Surveyed Sept. 29.. 1983., by L.M. TOLL.....

REVISED 2/22/88 GMB
DEN-ILL-50

BenB