


G-6470
57214

T. 1N, R. 20& 21E, W.M.

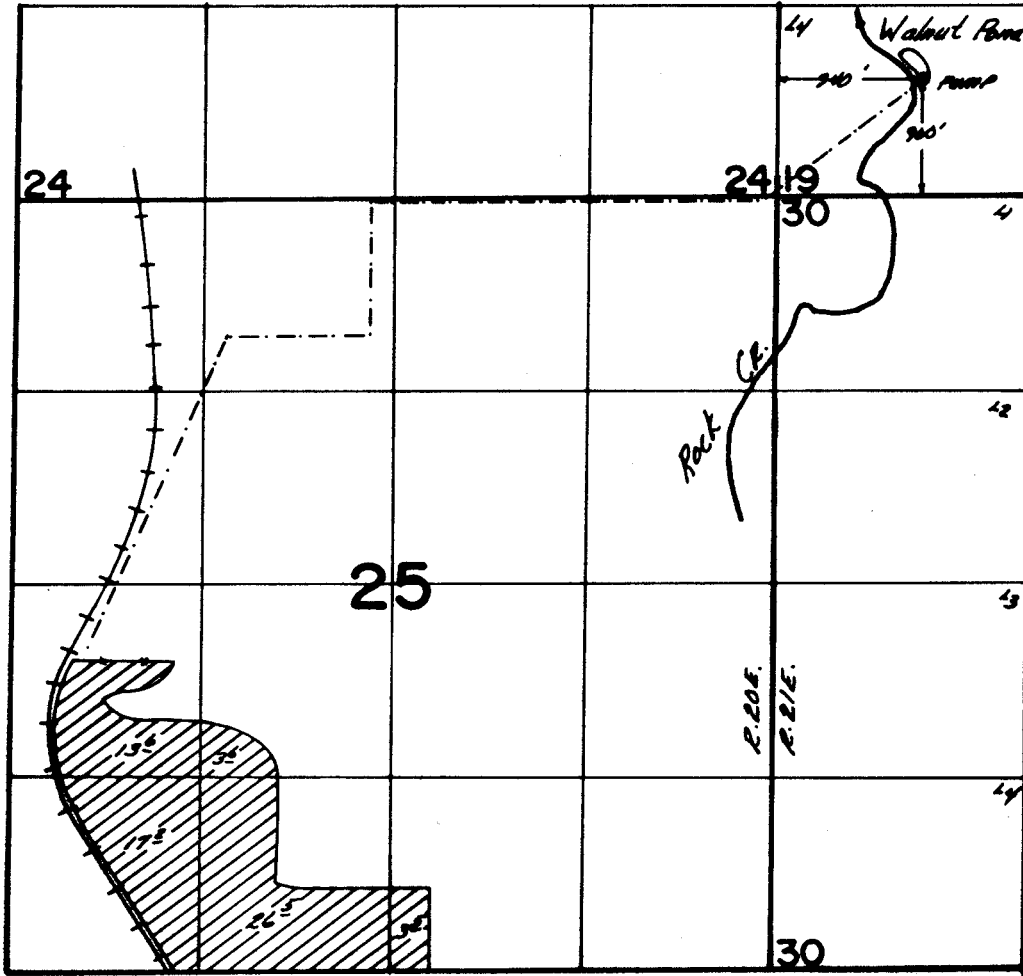

FINAL PROOF SURVEY UNDER

Application No. G-6958 Permit No. G-6470....
IN NAME OF

.....A. DAVID & PEGGY S. CHILDS.....

Surveyed June..13.. 1979., by S.C. BROWN.....