


T. 39S., R. 1E., W.M.

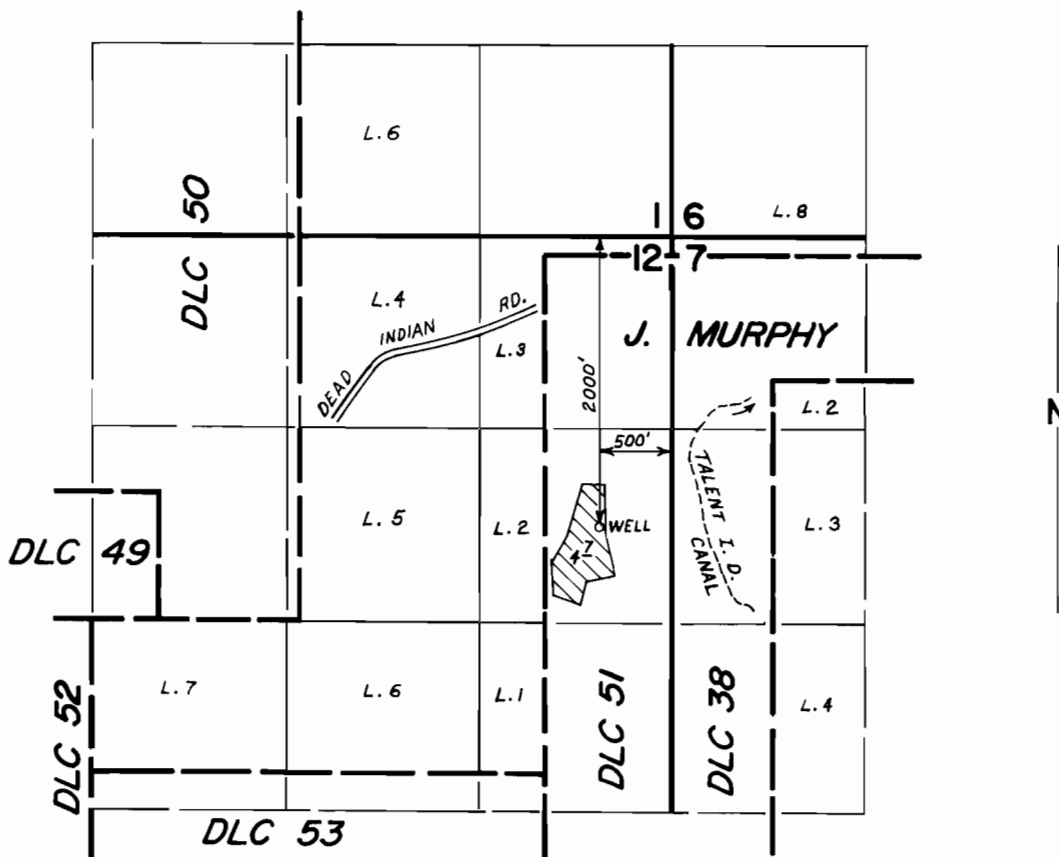

SCALE: 1" = 1320'

FINAL PROOF SURVEY UNDER

Application No. G-7091 Permit No. G-6559
IN NAME OF

JAMES C. MILLER

Surveyed JUNE 7, 1984, by B. S. JAMES