


G - 6640

57216

T. 4N., R. 25E., W.M.

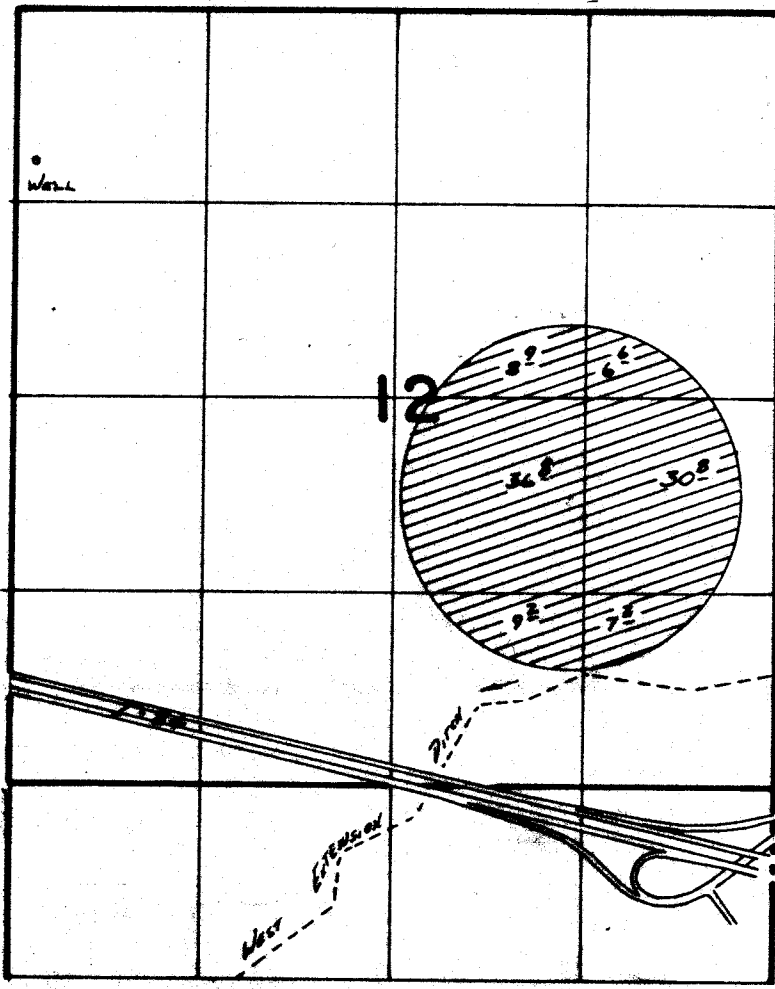

Well loc: 1030'S. + 120'E. From NW Cor. Sec 12

FINAL PROOF SURVEY UNDER

Application No. **G-7221**.. Permit No. **G-6640**
IN NAME OF

PORT OF MORROW COMMISSION

Surveyed 8-18..... 1983, by E.L. Church
11-7