


T. 6S., R. 3W., W.M.

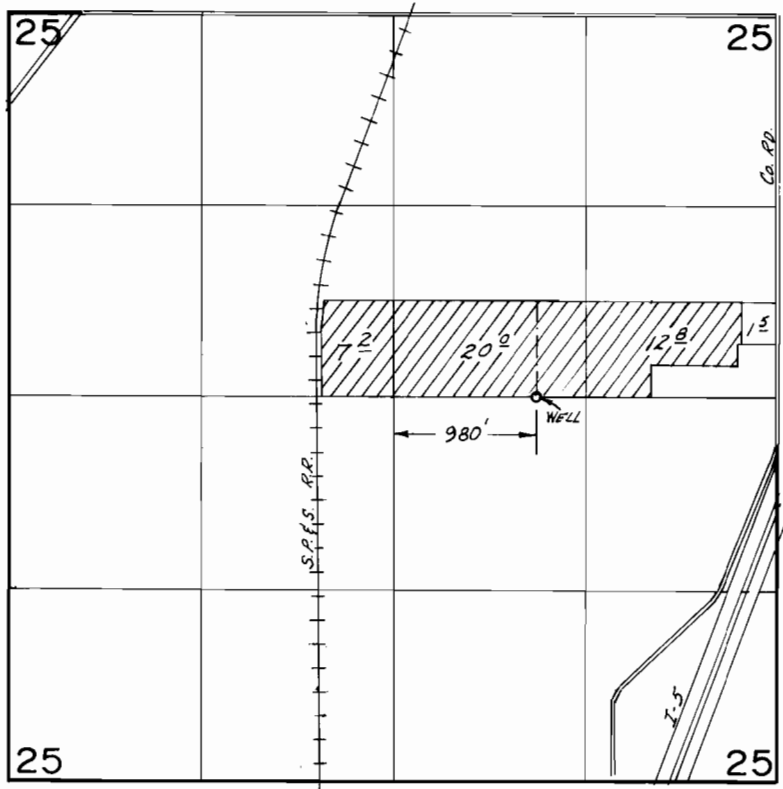

SCALE: 1"=1320'

FINAL PROOF SURVEY UNDER

Application No. G-7364 Permit No. G-6896
IN NAME OF

.....

Surveyed June 7, 1984, by B.W. BISHOP