90684

T. 1 N., R. 3 E., W.M.

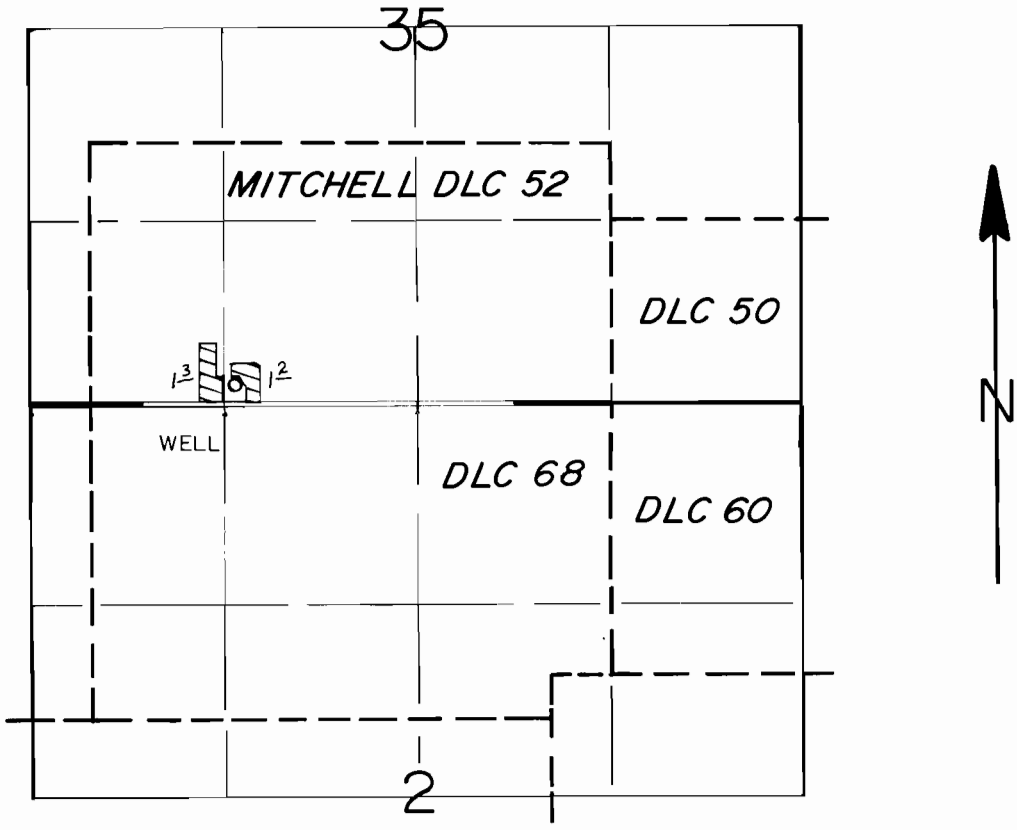

WELL LOC.: 140' NORTH AND 1400' EAST FROM THE S.W. COR. SECTION 35.

SCALE: 1" = 1320'

FINAL PROOF SURVEY

UNDER

Application No. G-7369 Permit No. G-6898

IN NAME OF

HARRISON MCKNIGHT

Surveyed MAY 21 1984, by P. R. PAGTER

DFO ILL 34 McB.