


T.2S., R.3W., W.M.

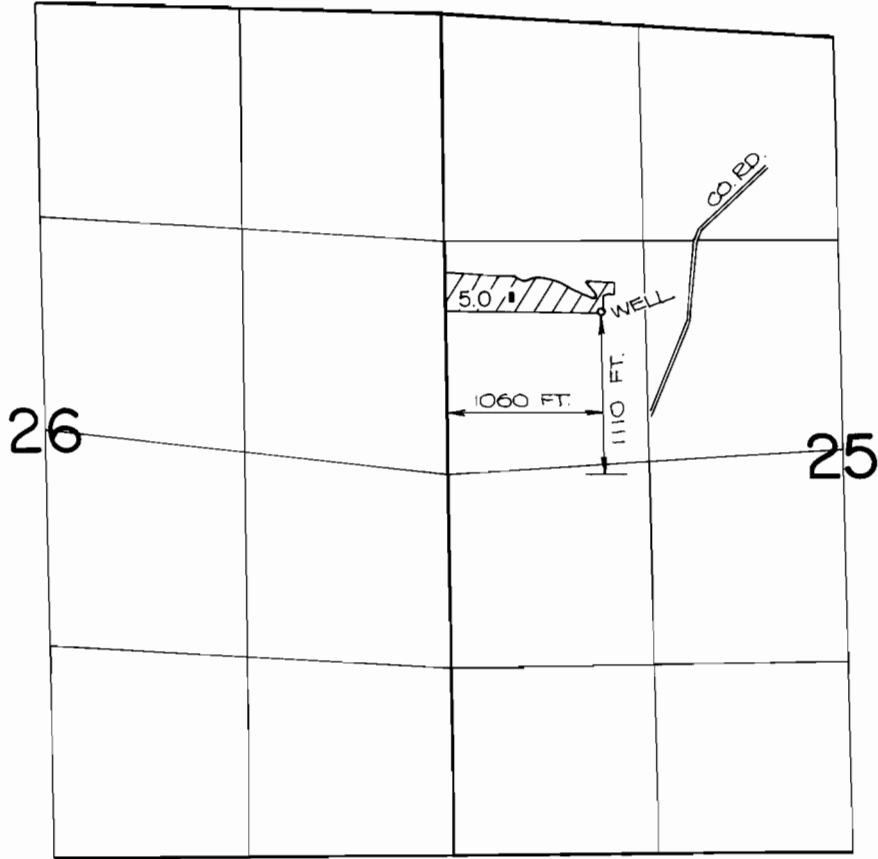

FINAL PROOF SURVEY
UNDER



Application No. G-7501... Permit No. G-6981.....
IN NAME OF

SCALE: 4" = 1 MILE

.....ARTHUR M. BROWN.....

Surveyed AUG. 20., 1984., by P. Paster.....