


T. 35 S., R. 2 W., W.M.

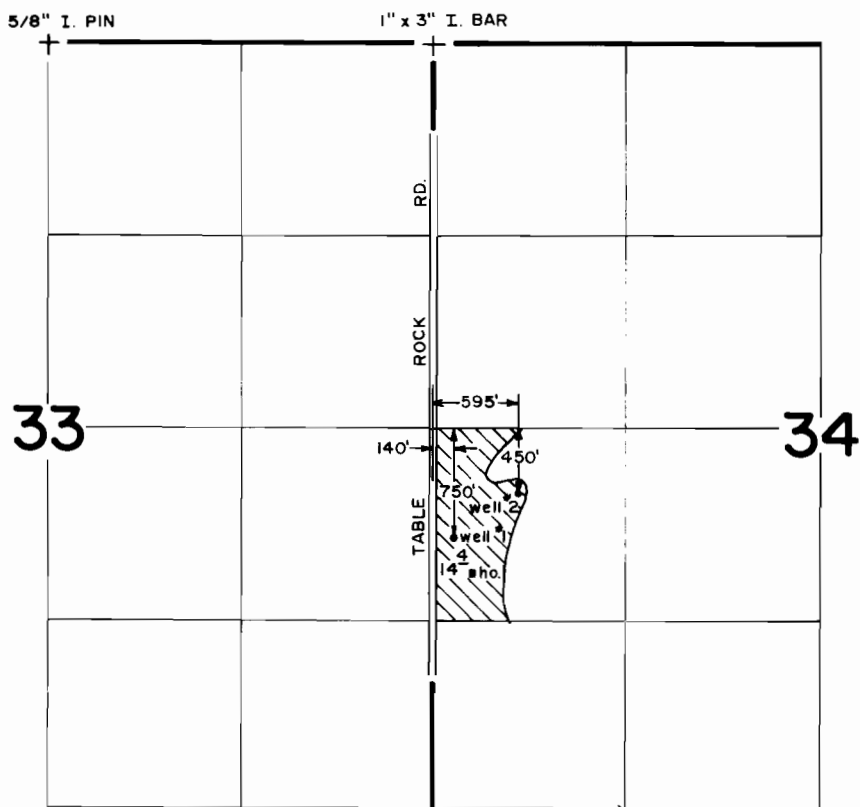

FINAL PROOF SURVEY
UNDER

Application No. G-7868 Permit No. G-7290
IN NAME OF

THOMAS H. HOLMES

Surveyed FEB. 2 1983, by B. S. JAMES

SCALE: 4" = 1 MILE