


G-7295
57227

T. 3 N. R. 35 E. W.M.

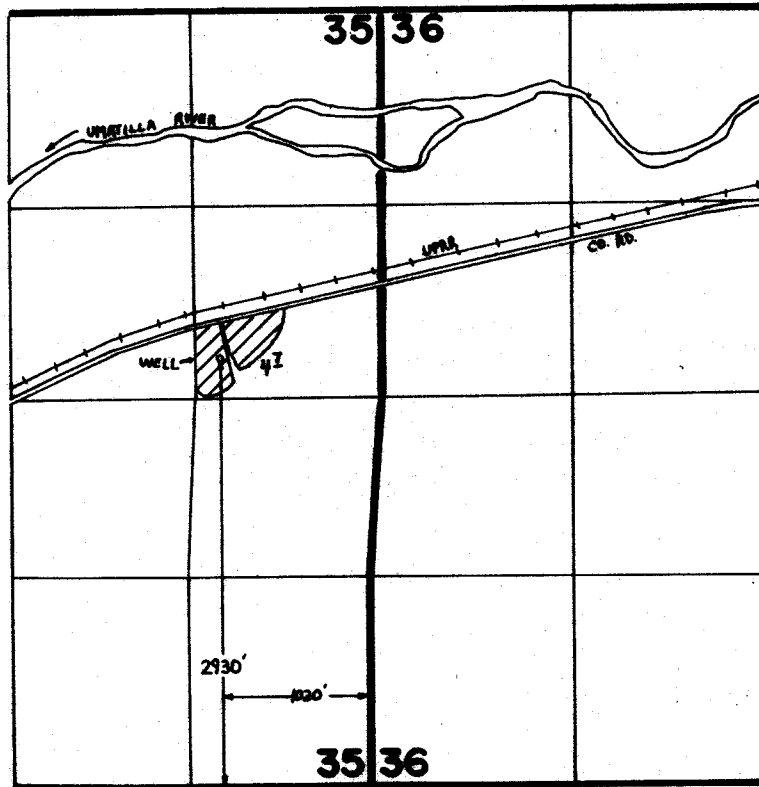

FINAL PROOF SURVEY UNDER

Application No. G.7295 Permit No. G.7295.....

IN NAME OF

DEPT. OF VETERAN'S AFFAIRS

.....DONALD A. BARBARA LAMBERT.....

Surveyed March 2, 1997, by V. Church.....