


# T.10S., R.4W., W.M.

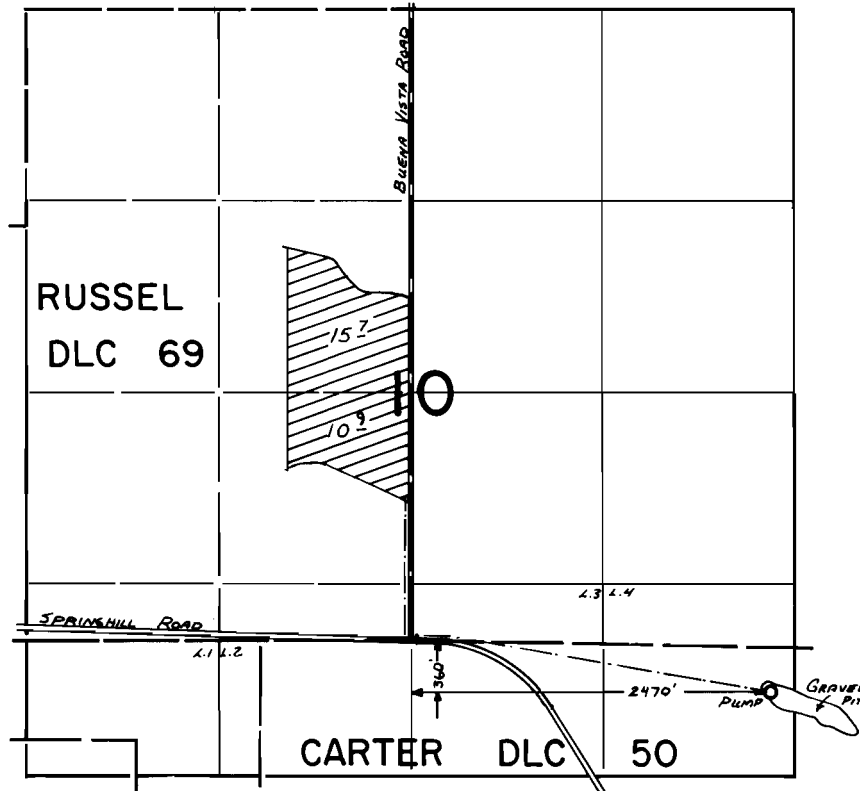

## FINAL PROOF SURVEY UNDER

Application No. G-7979 Permit No. G-7407.....  
IN NAME OF

.....KENNETH HOLMES.....

Surveyed Aug. 27, 1982, by L. M. TOLL.....