


T. 35S., R. 2W., W.M.

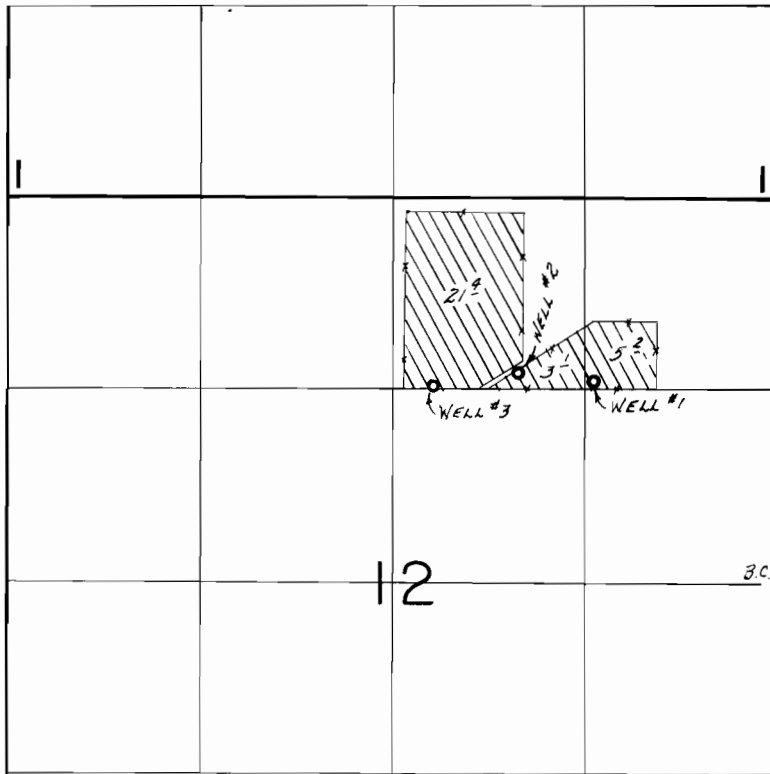

WELLS LOC.: #1- 1390' N. & 1250' W., #2- 1450' N. & 1770' W., #3- 1350' N. & 2350' W., ALL FROM THE E 1/4 CORNER SECTION 12.

SCALE: 1" = 1320'

FINAL PROOF SURVEY
UNDER

Application No. G-1085! Permit No. G-9964.....
IN NAME OF

.....MARY C. BENSON.....

Surveyed MAY 18.... 19.87., by B.S. JAMES.....

12/28/87
PUB