


T. 4 S., R. 2 E., W.M.

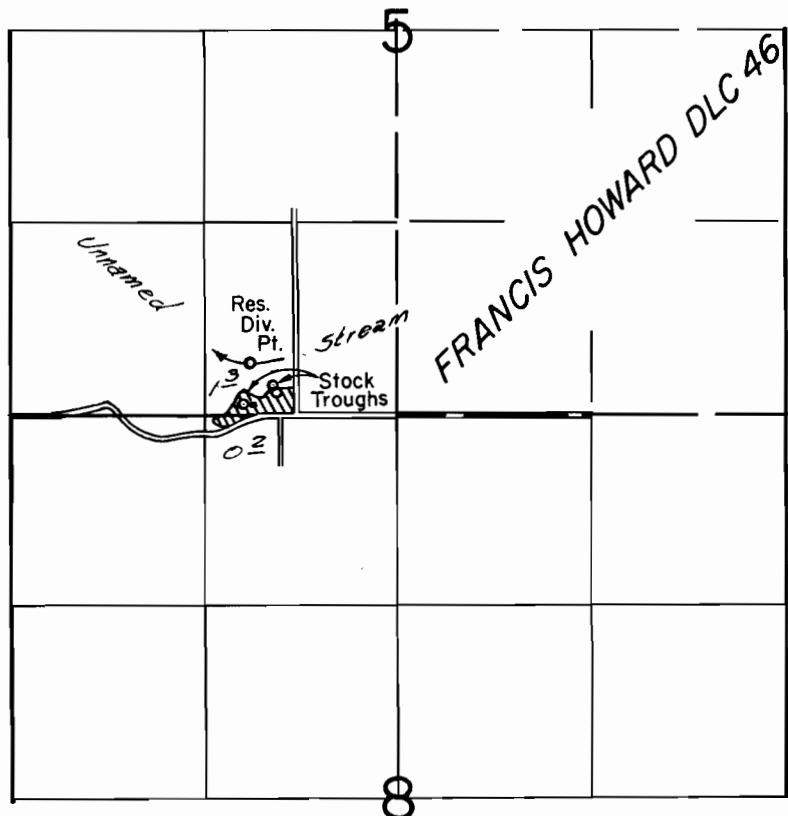

Div. Pt. Located: 370' N. & 1000' W. from the
5/4 Corner Section 5

FINAL PROOF SURVEY
UNDER

R-50312 R-6146
Application No. 50313 Permit No. 37987

IN NAME OF

DENNIS N. EASLY

Surveyed MAY 21, 1980, by *W. Brown*