


T.40S., R.4W., W.M.

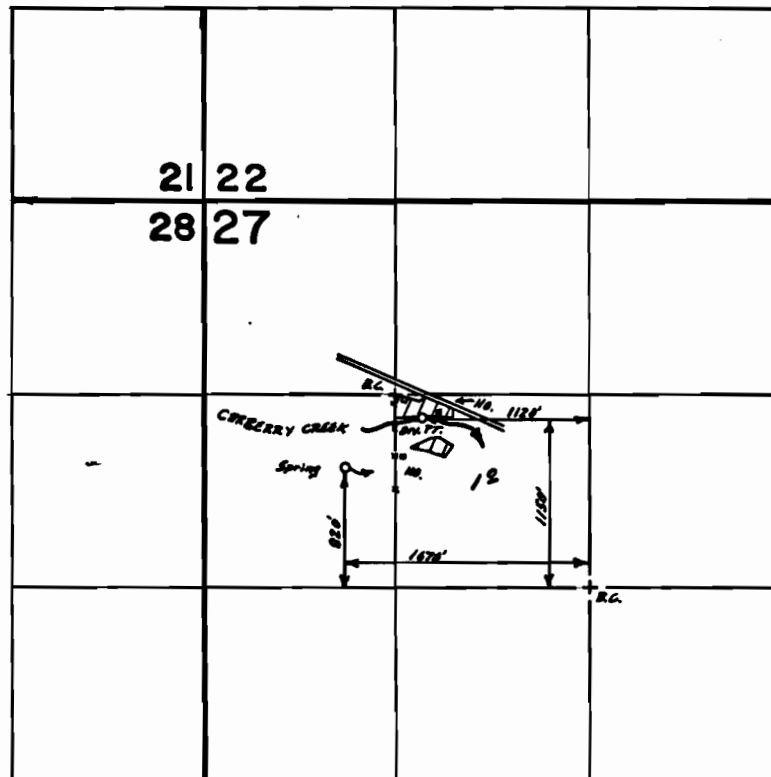

Scale 1"=1320'



FINAL PROOF SURVEY
UNDER

50155 37678

Application No. 55154 Permit No. 41398

IN NAME OF

JAY W. & or JANICE A. COOPER

Surveyed Oct. 11, 1978, by B. R. SUND
June 22, 1982