


T.5S.,R.5W.,W.M.

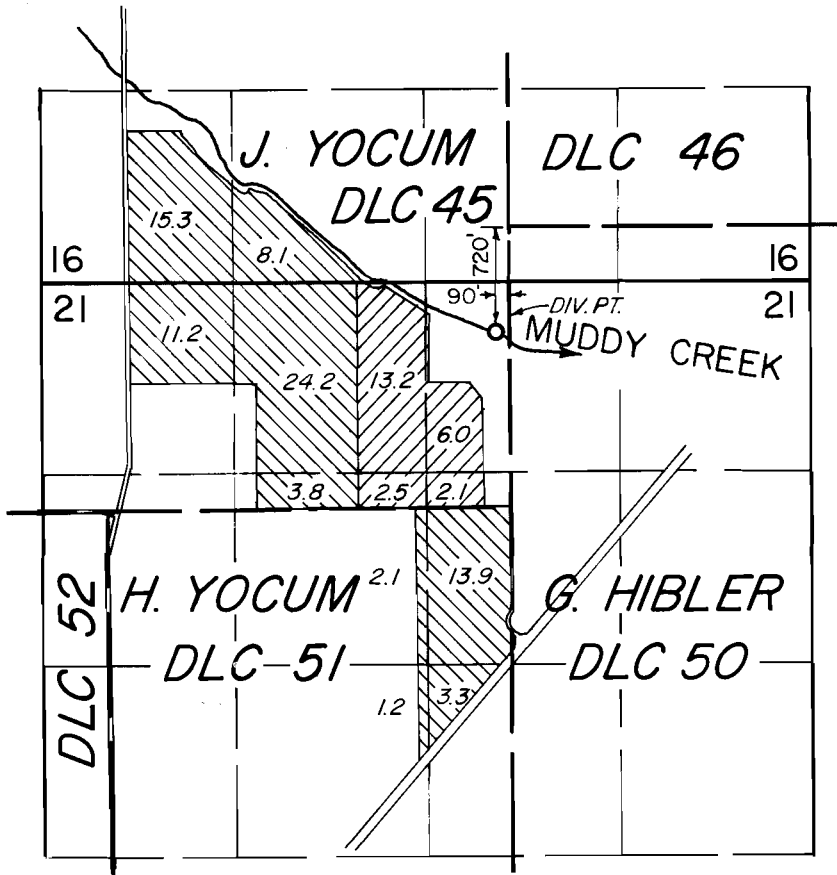

FINAL PROOF SURVEY UNDER

Application No. 50464 50647 Permit No. 36770 38265

IN NAME OF

JOHN M. McDANIEL

Surveyed MAY 30, 1979, by *dlb*