


T. 3S., R. 44E., W. M.

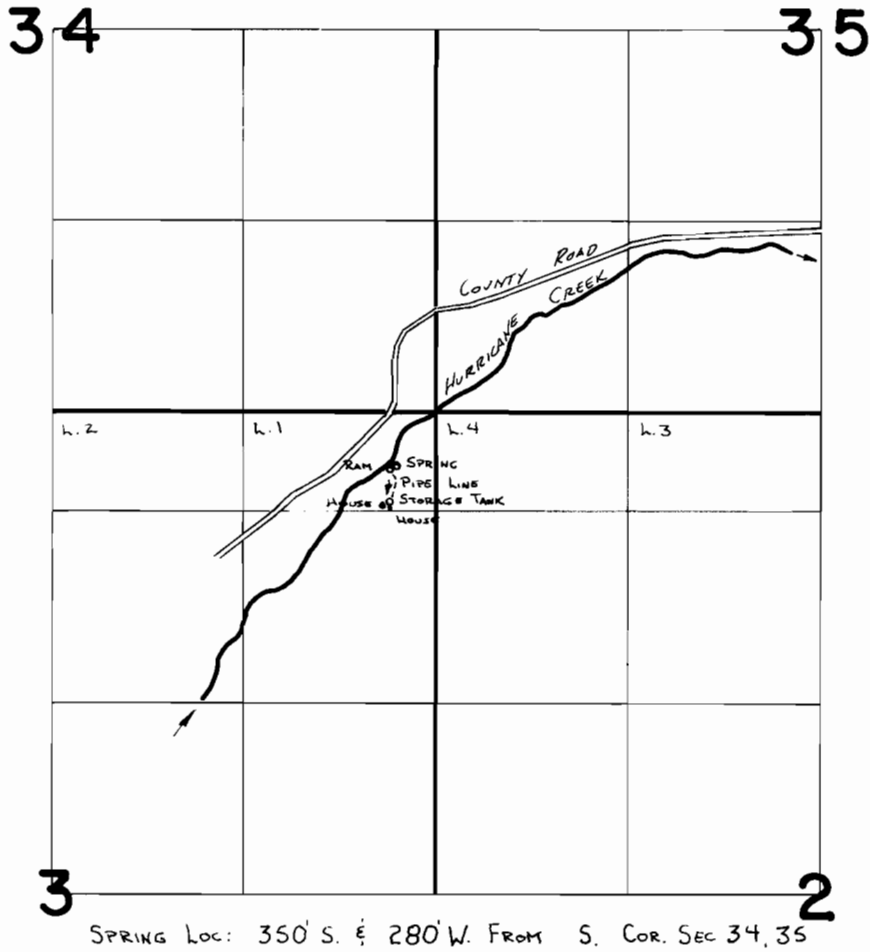

**FINAL PROOF SURVEY**  
UNDER

Application No. **49851** Permit No. **37489**  
IN NAME OF

**MYRL DUNLAP**

Surveyed **8-8** 19**84**, by **V. L. Church**