


T. 35 S., R. 1 W., W.M.

SEC. 29 & 32

Scale: 1" = 400'

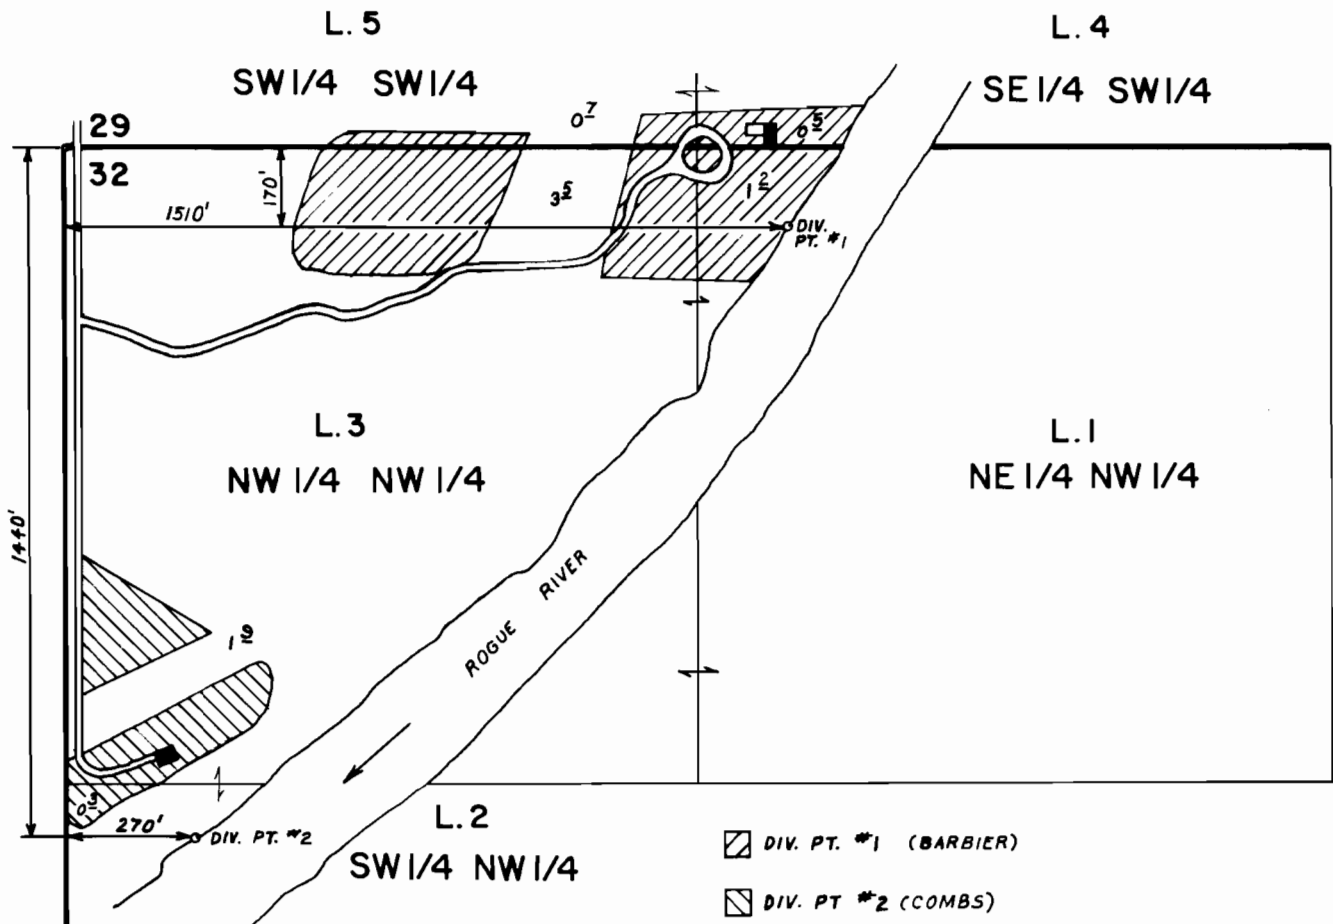

FINAL PROOF SURVEY
UNDER

Application No. 49993 Permit No. 37599
IN NAME OF

JOHN F. BARBIER & JOAN F. COMBS

Surveyed JULY 12, 1983, by B. S. JAMES