


T. 1S., R. 43E., W. M.

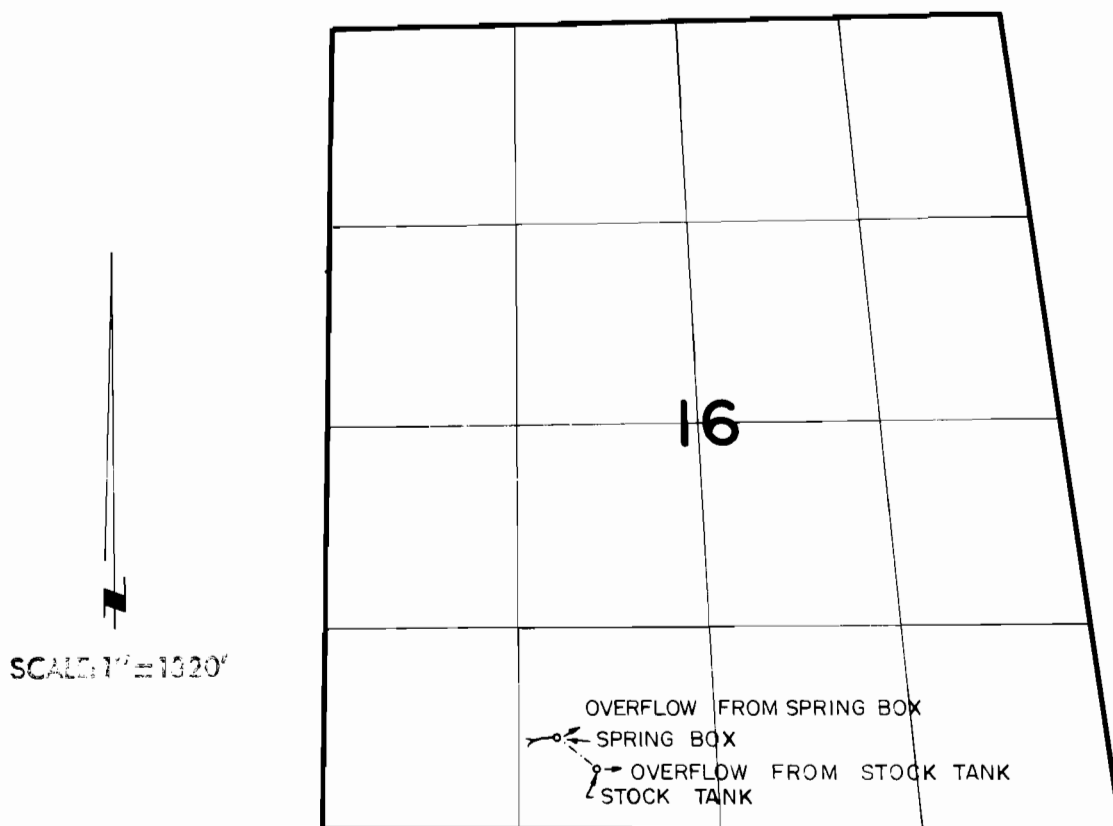

SPRING BOX LOC. 620'N & 1600'E. FROM SW COR. SEC. 16

FINAL PROOF SURVEY

UNDER

Application No. **51217** Permit No. **37789**
IN NAME OF

NANCY F. WALTON CAREY

Surveyed **8-13** 19**85**, by **V. L. Church**