


T.19S.,R.3W.,W.M.

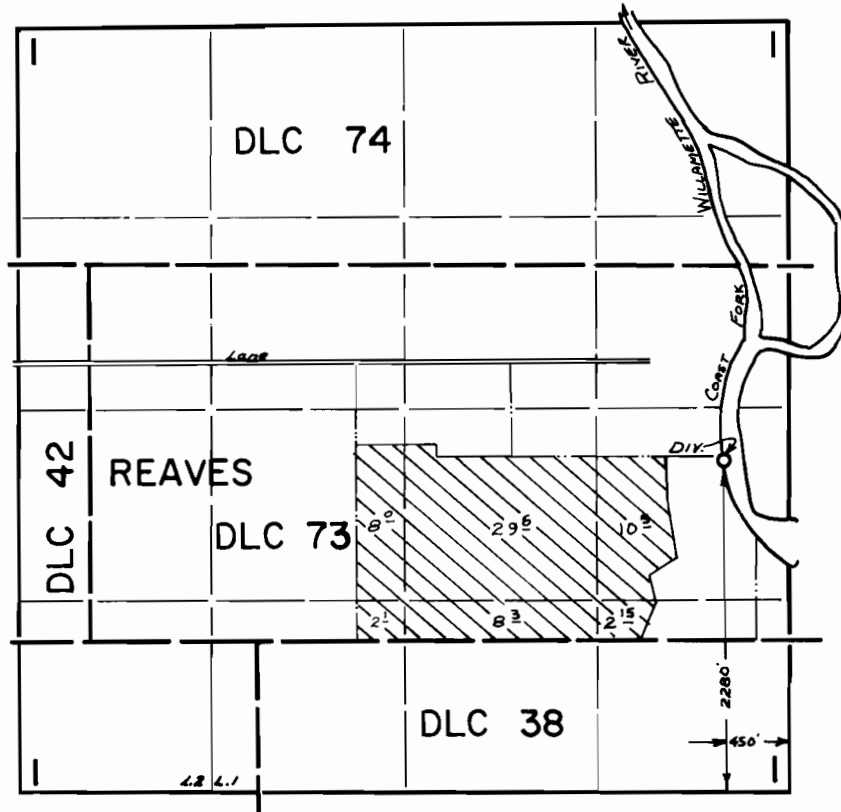

FINAL PROOF SURVEY
UNDER

Application No. 52661... Permit No. 37809.....
IN NAME OF

RAY C. ANDREWS

Surveyed Sept. 15, 1981., by S.C. BROWN.....