


T.14S. R.11W. W.M.

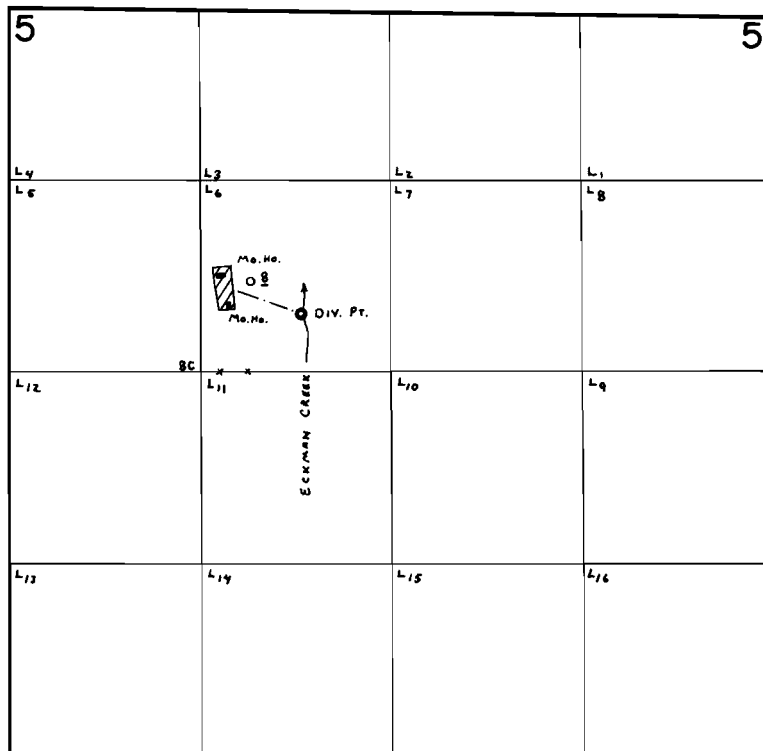

Div. Pt. Loc: 400' N. & 690' E. fr. S.W. Cor. Lot 6.

FINAL PROOF SURVEY UNDER

Application No. 50334 Permit No. 37999
IN NAME OF

VIRGIL O. MYERS

Surveyed May 22, 1980, by C. L. Hughes