


T. 24 S., R. 5 W., W.M.

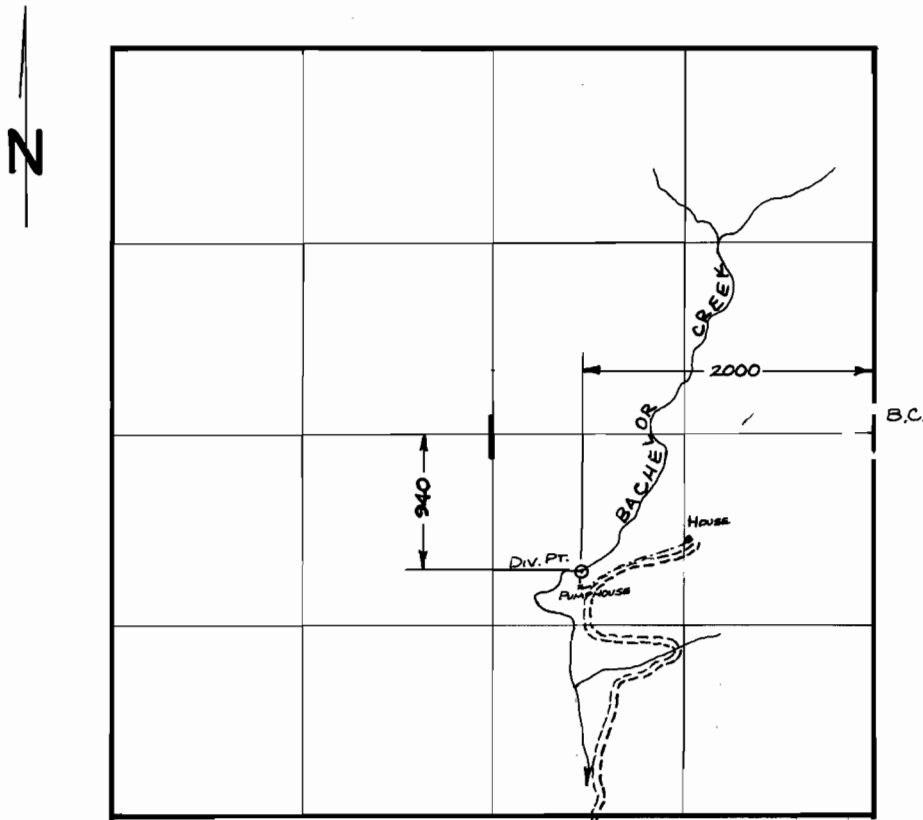

SCALE: 4" = 1 MILE

FINAL PROOF SURVEY

UNDER

Application No. .51052.... Permit No. ...38526....
IN NAME OF

LARRY & ELIZABETH CARTER

Surveyed 12/30/83, 19.87., by J.M. SCHMORDE..