


T6S. R7W. WM.

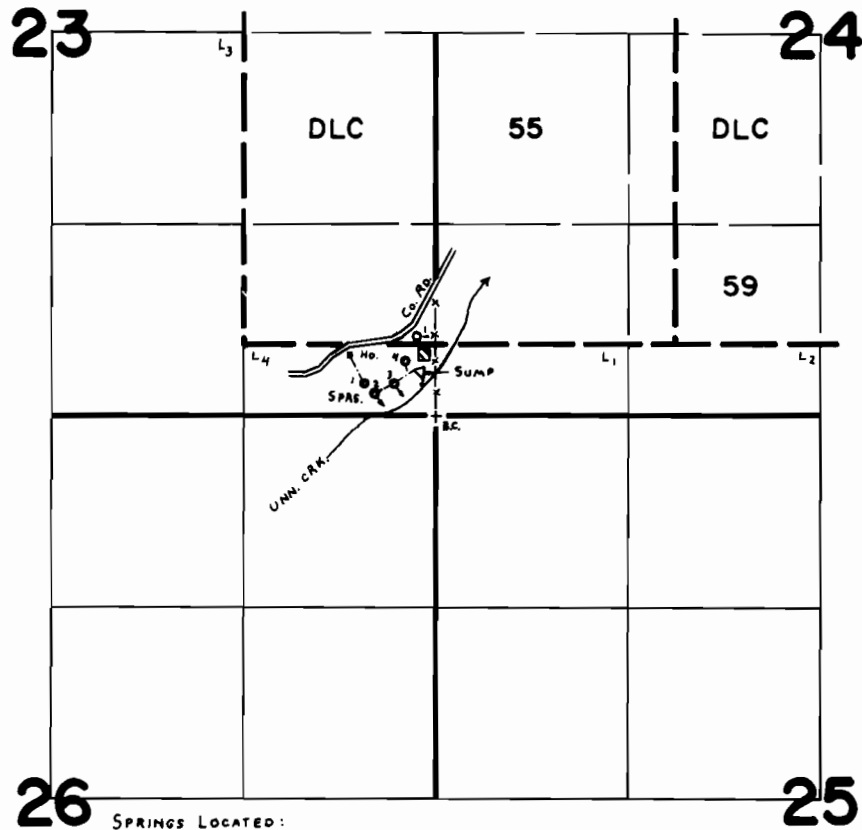

SPRINGS LOCATED:
 #1- 225' N. & 480' W.
 #2- 180' N. & 420' W.
 #3- 220' N. & 280' W.
 #4- 380' N. & 200' W. } ALL FROM SE. COR. SEC. 23.

FINAL PROOF SURVEY UNDER

Application No. 51270. Permit No. 38719.....
 IN NAME OF

ROBERT A. DEFOREST

Surveyed June 7 1979, by C. L. HUGHES.....