

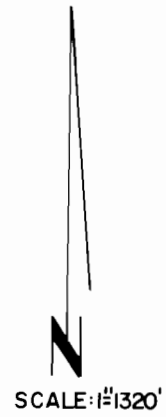


T. 1 S. R. 44 E. W. M.

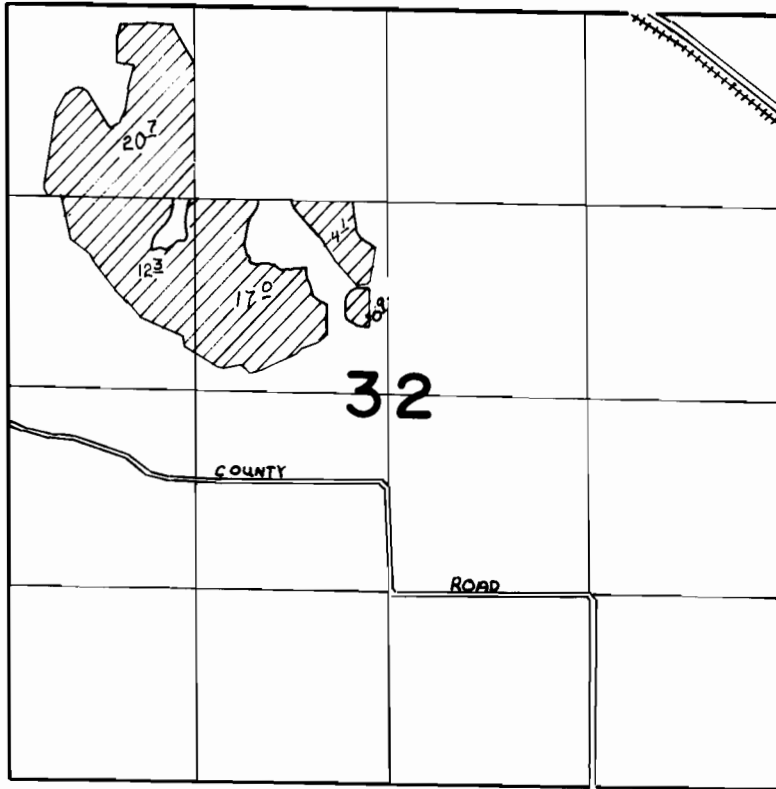

T. 2 S. R. 44 E. W. M.

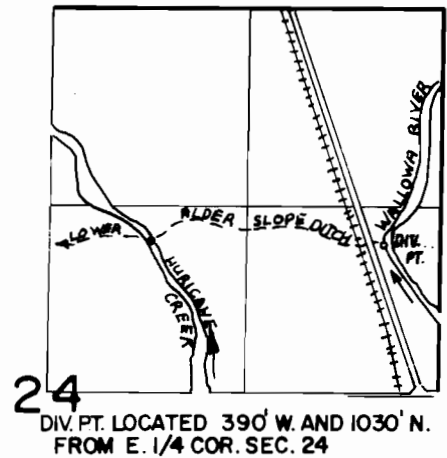

**FINAL PROOF SURVEY**  
UNDER

Application No. 52082... Permit No. 39244.....  
IN NAME OF

.....**MOORE BROTHERS**.....

Surveyed Aug. 6..... 1984., by **V. L. CHURCH**.....