


T. 35 S., R. 6 W., W. M.

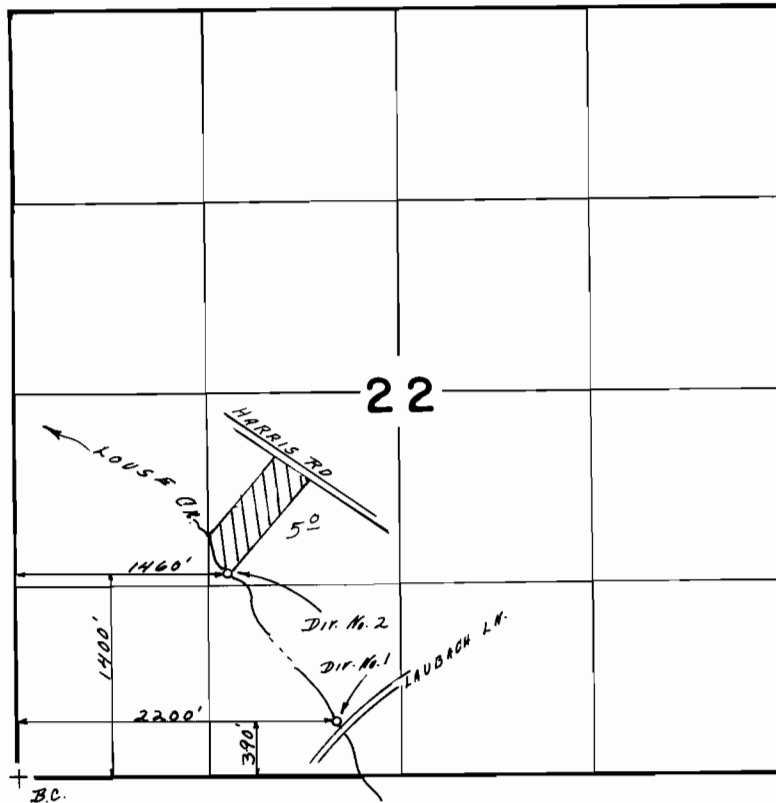

Scale: 1" = 1320'

**FINAL PROOF SURVEY**  
UNDER

Application No. 52318 Permit No. 39354  
IN NAME OF

HARRY ARNOLD REID

Surveyed AUG. 25, 1986, by B. S. JAMES