


T.28 S., R.7 W., W.M.

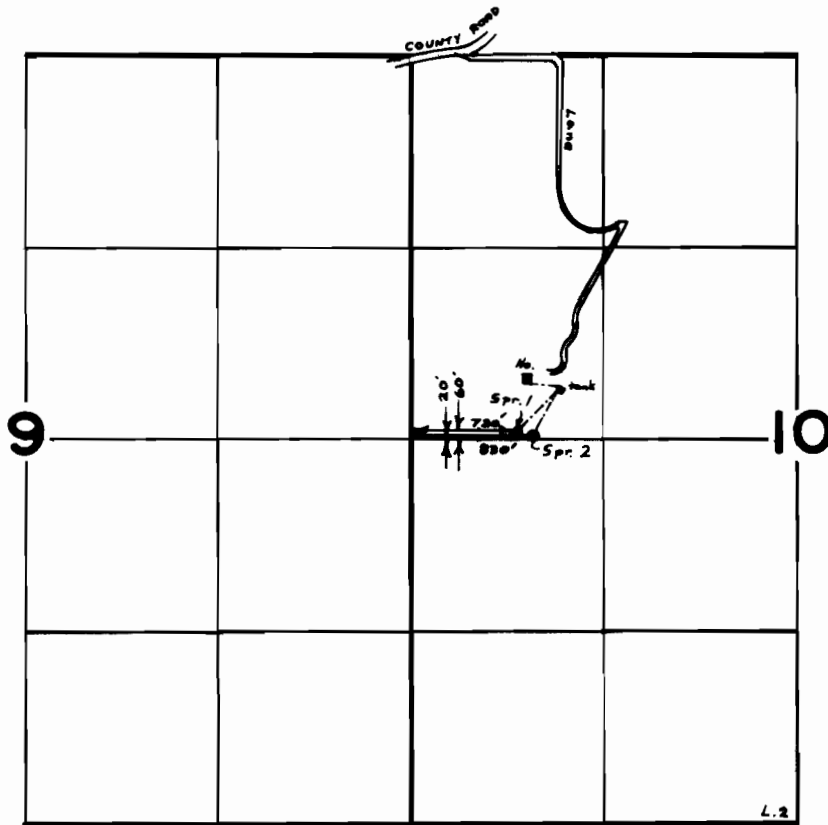

SCALE 4" = 1 mile

**FINAL PROOF SURVEY**  
UNDER

Application No. 55192... Permit No. 41405..  
IN NAME OF

LYNN AND JOHN W. BARR, JR.

Surveyed June 7, 1979, by S. Donaldson.