


T. 3 S., R. 9 W., W.M.
SEC. 6

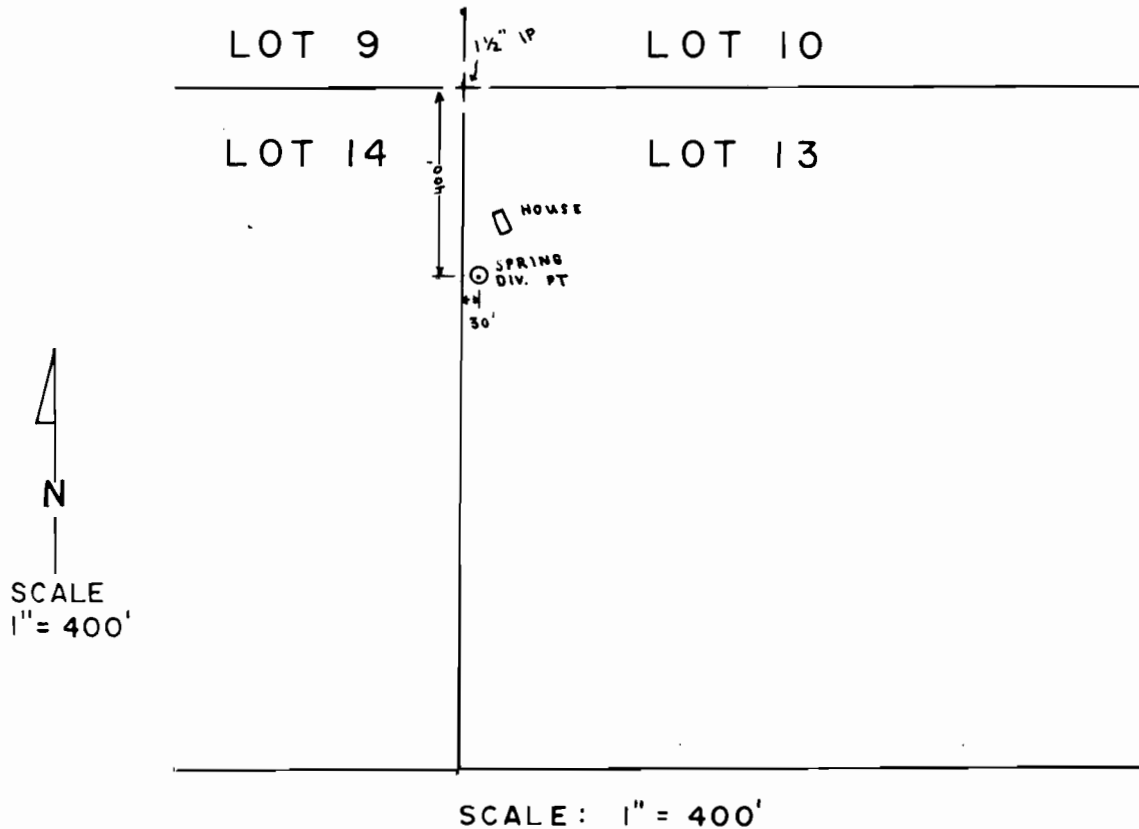

FINAL PROOF SURVEY
UNDER

Application No. 56096 Permit No. 41978
IN NAME OF

STEPHEN R. HERCHER

Surveyed OCT. 13, 1983, by PAGTER, P.