
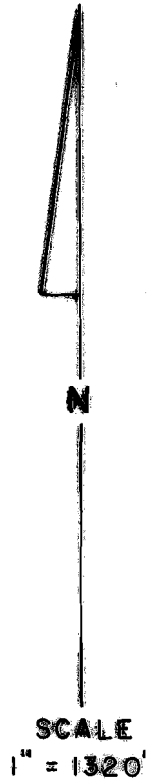


T. 2 S., R. 9 W., W.M.

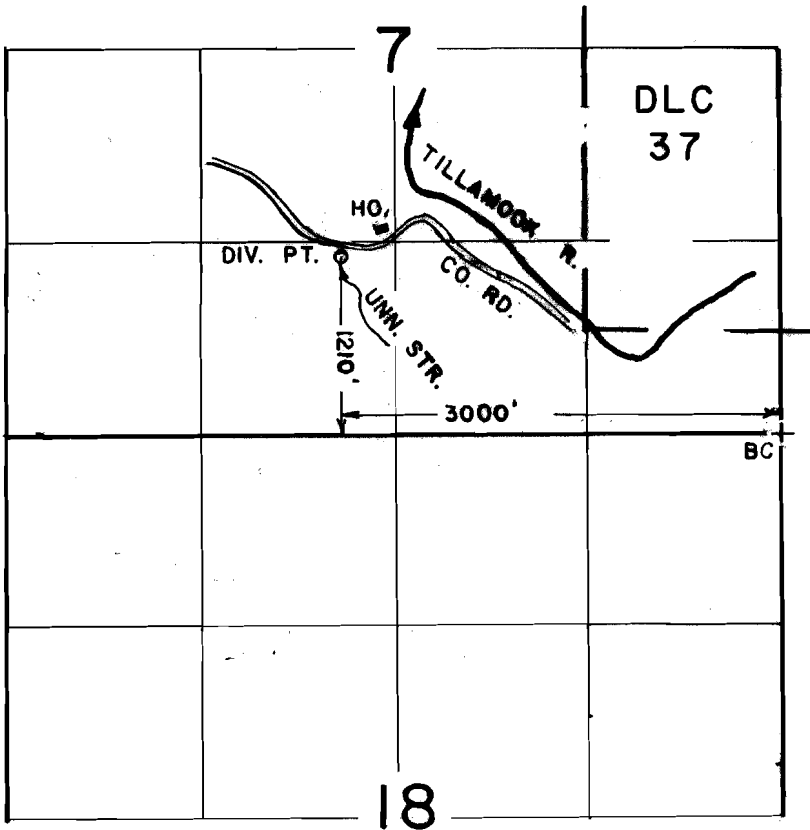

**FINAL PROOF SURVEY**  
UNDER

Application No. 61154... Permit No. 45504...  
IN NAME OF

LINDA MAE SAMPSON

Surveyed JUL 30 1984, by P. PASTER