

Application No. 61957


Permit No. 45893

T.40 S. R.3 W. W.M.

RECEIVED

JUL 27 1981

WATER RESOURCES DEPT
SALEM, OREGON

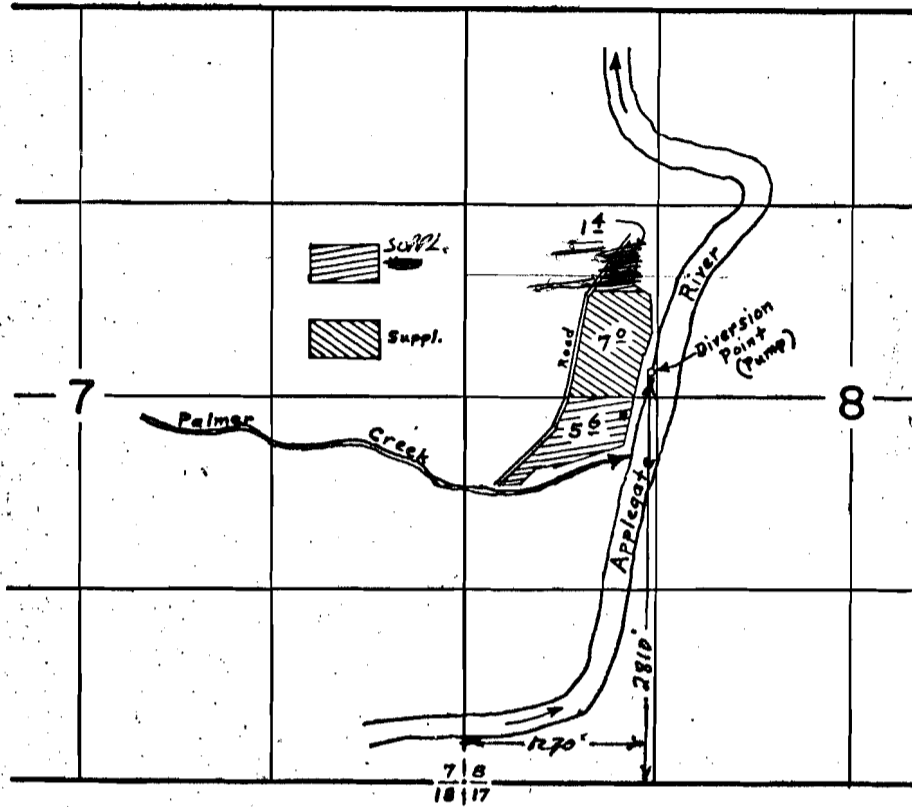

MAP TO ACCOMPANY APPLICATION OF
PHYLLIS HASELTINE FOR SUPPL. IRRIGATION
FROM APPLGATE RES. PER. # R-7810

FINAL PROOF SURVEY
UNDER

Application No. ~~37755~~ Permit No. ~~28015~~
IN NAME OF

~~John G. Pearlman~~

Surveyed May 20, 1963, by C. Baker