


RECEIVED

AUG 12 1981

WATER RESOURCES DEPT
SALEM, OREGON

T.36 S.R.1&2.W.W.M.

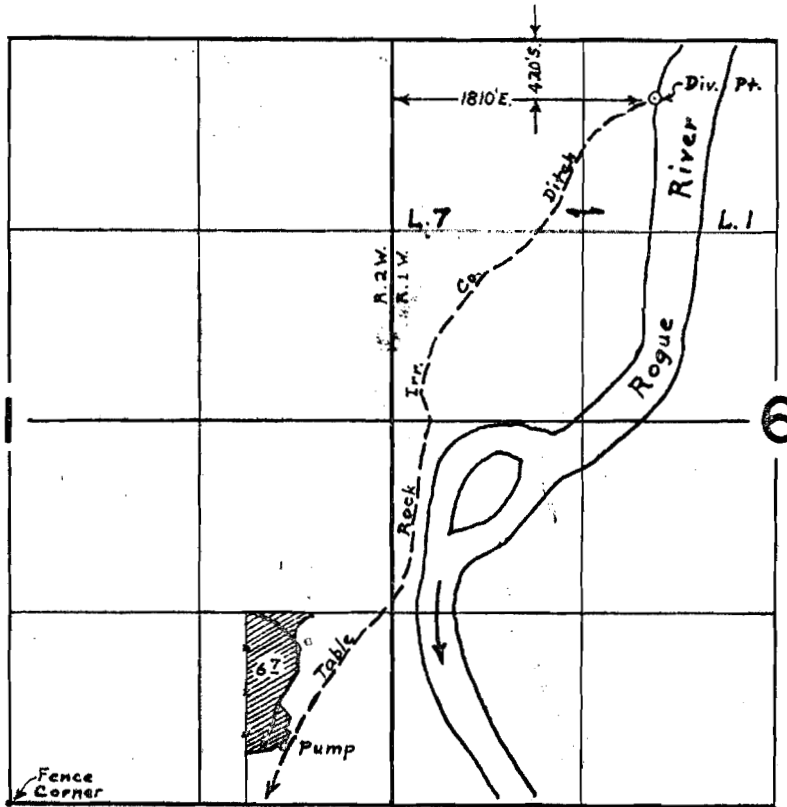

Map to accompany application for stored water from Lost Creek Reser-
voir constructed under Permit No. R-8142 for the use of 14 acre feet
of stored water for supplemental irrigation purposes...filed in the
names of Henry P. Delladio and/or Bonita R. Delladio.

~~FINAL PROOF SURVEY
UNDER~~

~~Application No. 37717..... Permit No. 28120..... CERT. 34766
IN NAME OF~~

~~JAMES A. LEWIS~~

~~Surveyed June 2, 1966, by L.E. Gould
February 14, 1968, by D.L. Hendrix~~

dat **RECEIVED**
6-5-81 JUN 8 1981

WATER RESOURCES DEPT
SALEM, OREGON

Application No. 61761
Permit No. 45929