


T.40 S.R.3 W.W.M.

Application No. 62029
Permit No. 45947

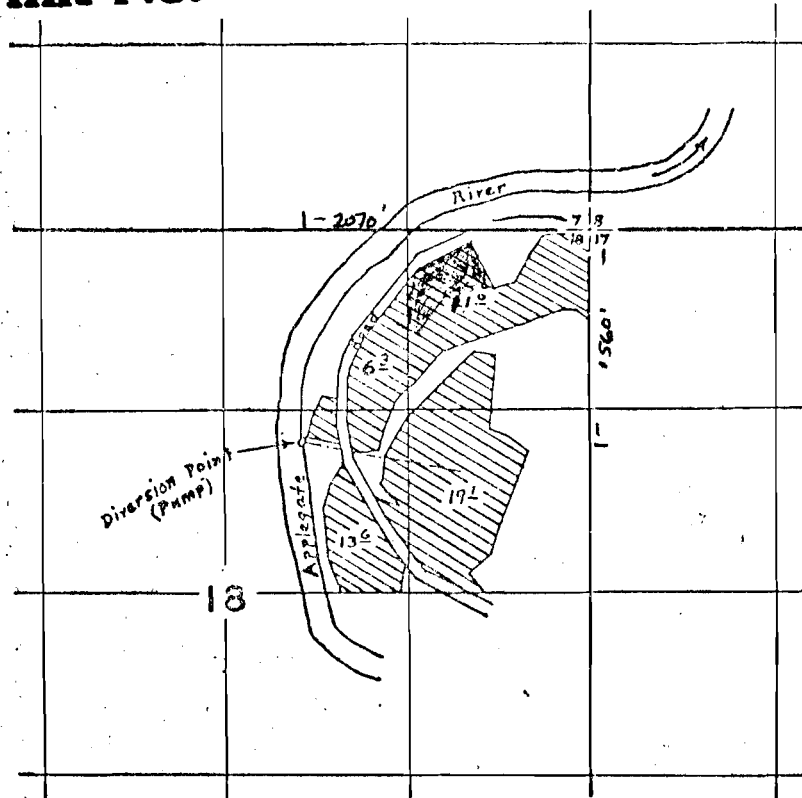

Map to accompany application of Morris Byrne to appropriate 50 acre feet of stored water from Applegate Lake Reservoir to supplementally irrigate the above shaded lands.

~~FINAL PROOF SURVEY
UNDER~~

~~Application No. 31716 Permit No. 25003
IN NAME OF~~

~~Morris & Hazel Byrne~~

~~Surveyed May 23, 1963, by C Baker~~

CERT. 33154

RECEIVED

JUL 31 1981

WATER RESOURCES DEPT

SALEM, OREGON