



8 46212 57260
47339 57261
72459

T. 3S., R. 27E., W.M.

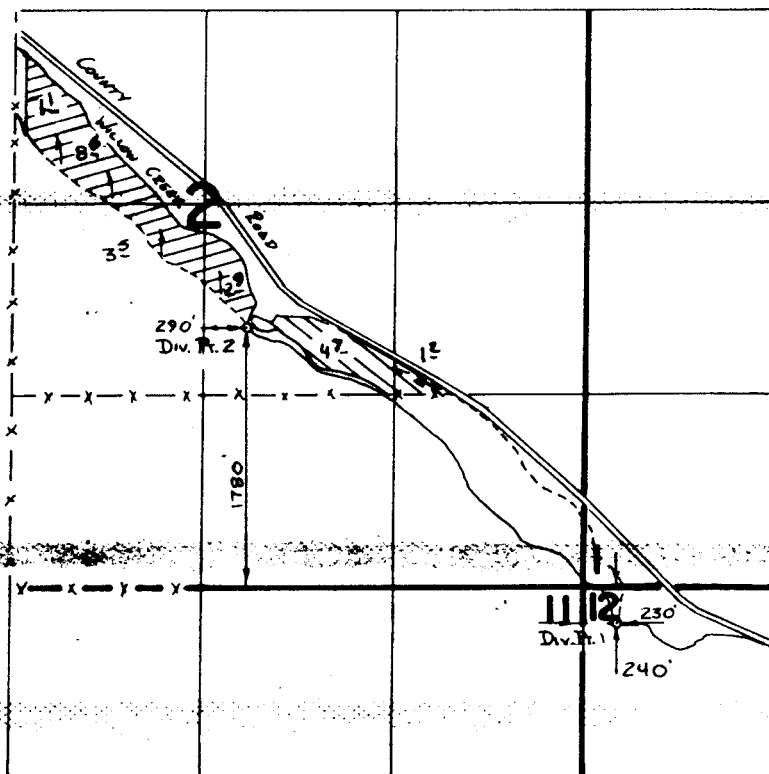

SCALE 1" = 1320'

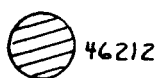

46212



47339

FINAL PROOF SURVEY
UNDER

Application No. **61083** Permit No. **46212**
64585 **47339**
IN NAME OF

FAY P. PAGE

Surveyed **10-27-1987**, by **V.L. GURRALL**