


8 46212 57260
47339 57261
72459

T. 3S., R. 27E., W.M.

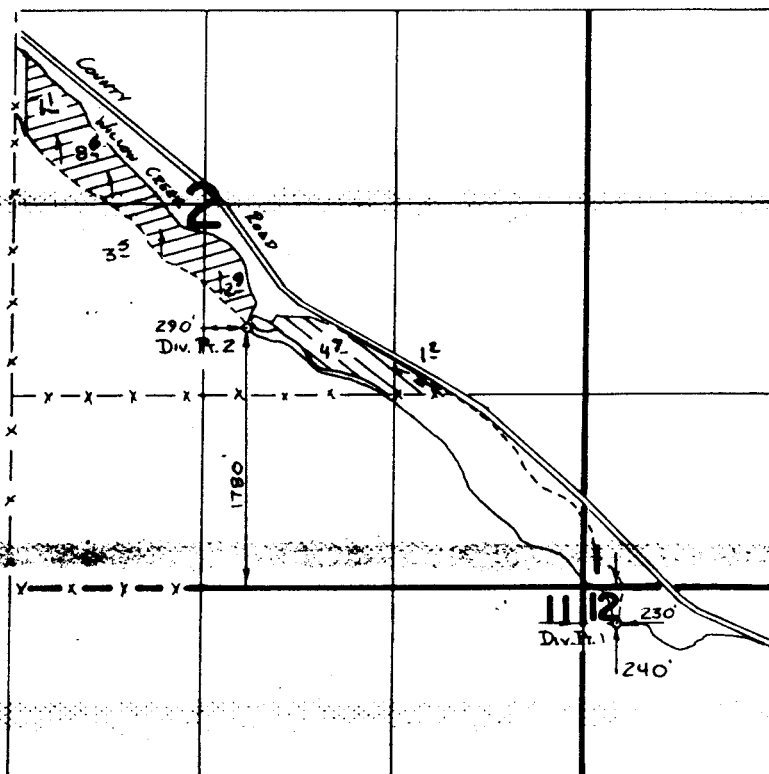

SCALE 1" = 1320'



FINAL PROOF SURVEY
UNDER

Application No. **61083** Permit No. **46212**
64585 **47339**
IN NAME OF

FAY P. PAGE

Surveyed 10-27-1987, by V.L. GURRALL