


RECEIVED

AUG 10 1981

WATER RESOURCES DEPT
SALEM, OREGON

T.38S. R.3W. W.M.

Application No, 62190
Permit No. 46389

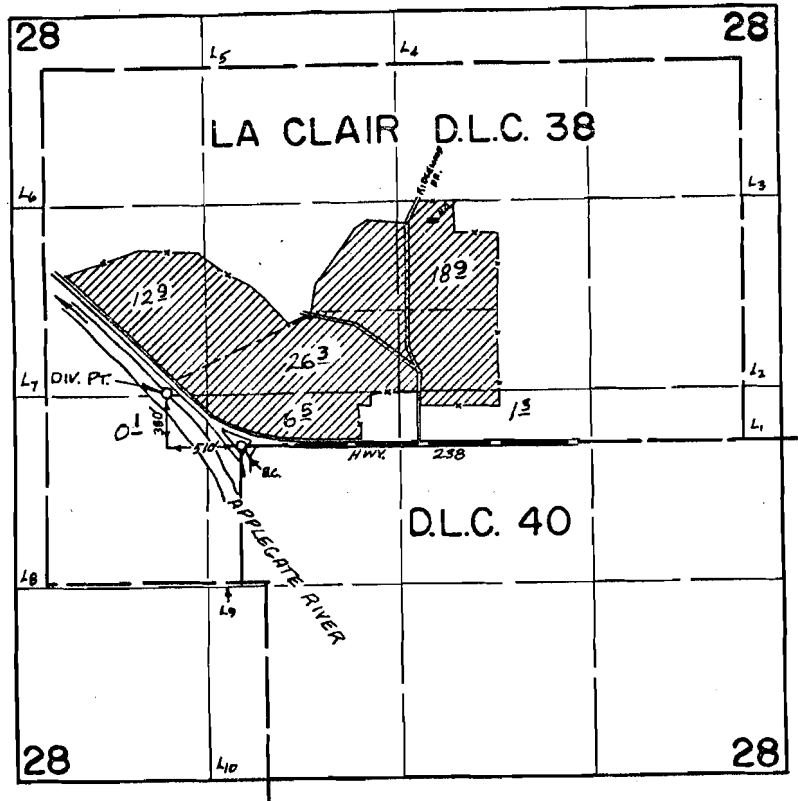

Map to accompany application of Russell R. and/or Genevieve O. Mee to appropriate 66 acre feet of water for supplemental irrigation of 66 acres shown above. Source of water from Applegate Lake Reservoir.

FINAL PROOF SURVEY
UNDER

~~Application No. 45100. Permit No. 33703~~
IN NAME OF

RUSSELL R. AND/OR GENEVIEVE MEE

Surveyed AUG. 11, 1975, by L. TOLL

RECEIVED

OCT 28 1981

WATER RESOURCES DEPT
SALEM, OREGON