


T.8S. R.4W. W.M.

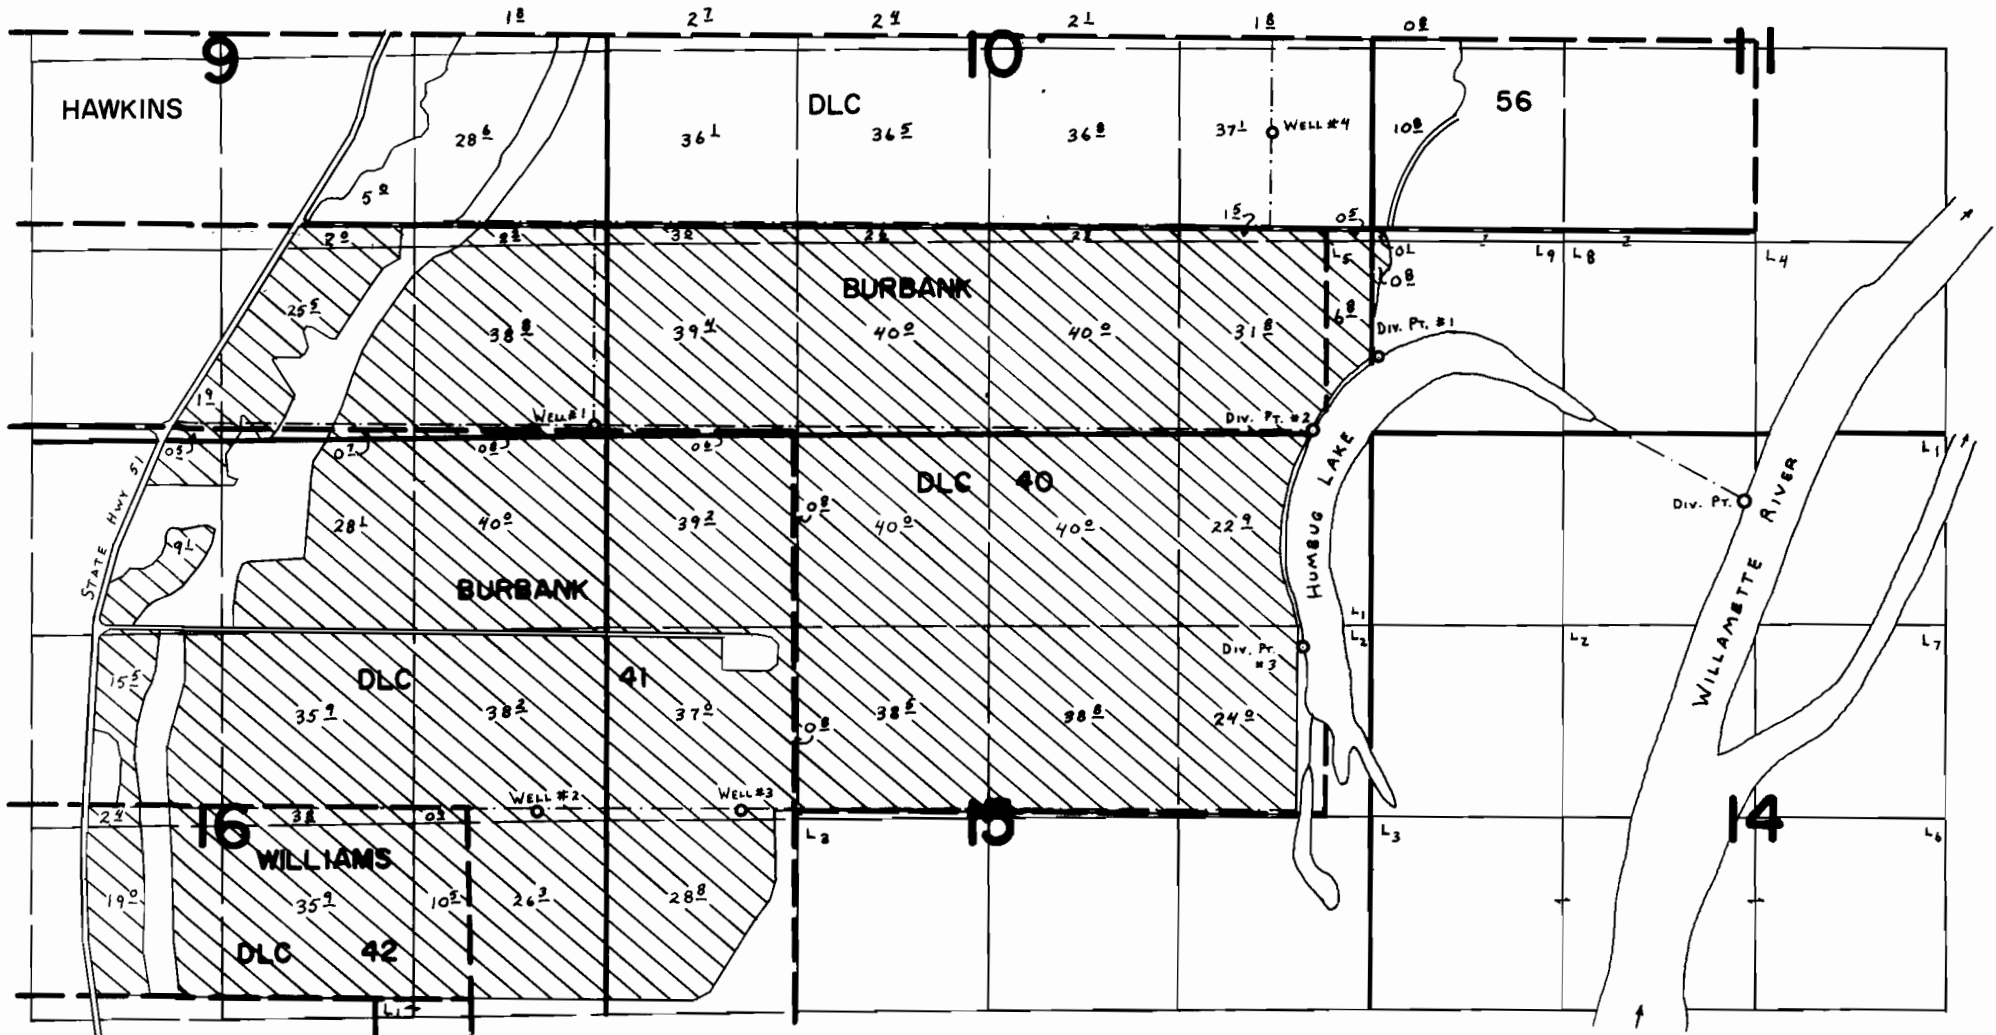

Div. Pts. Loc:

WILLAMETTE R. - 460' S. & 2560' E.

HUMBUG L. -

#1- 520' N. & 50' E.

#2- 30' N. & 400' W.

#3- 1460' S. & 470' W.

} ALL FROM N.W. COR. SEC. 14.

WELLS LOC:

#1- 30' N. & 1370' W.

#2- 2620' S. & 1770' W.

#3- 2600' S. & 370' W.

} ALL FROM N.E. COR. BURBANK D.L.C. 41.

FINAL PROOF SURVEY

UNDER

G-6230

G-5826

Application No. 50872 Permit No. 38409

IN NAME OF

GREEN VILLA FARMS

Surveyed May 17, 1979, by C. L. HUGHES