


T. 4S.R.2W. W.M.

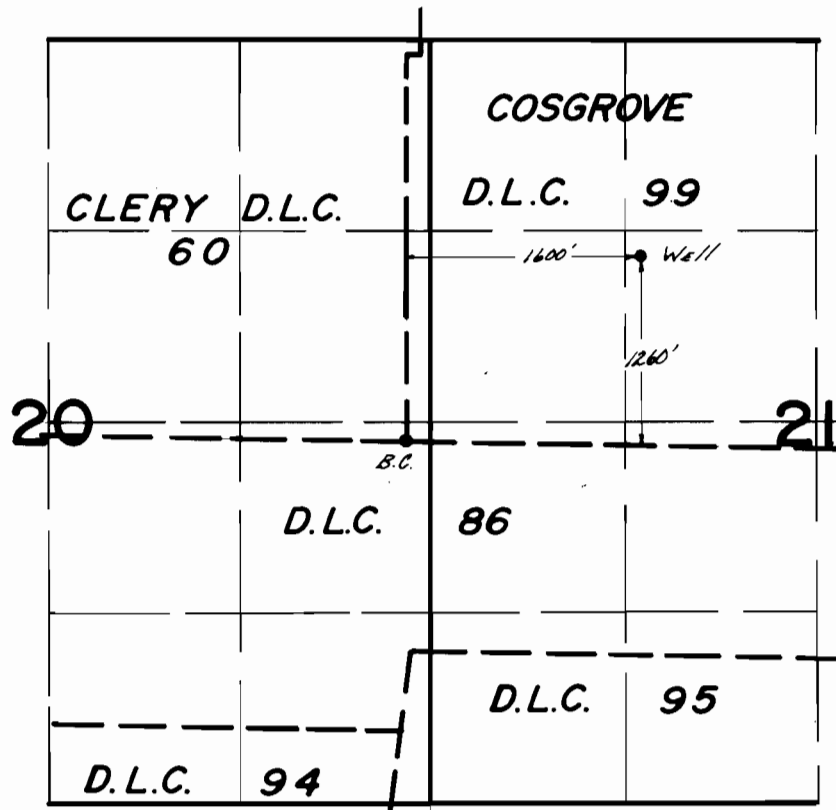


FINAL PROOF SURVEY
UNDER

Application No. G-7170 Permit No. G-6609...
IN NAME OF

.....**ELMER GOODING**.....

Surveyed Oct. 17... 1979, by C.R. RODRIGUEZ.

T.4S. R.2W. W.M.

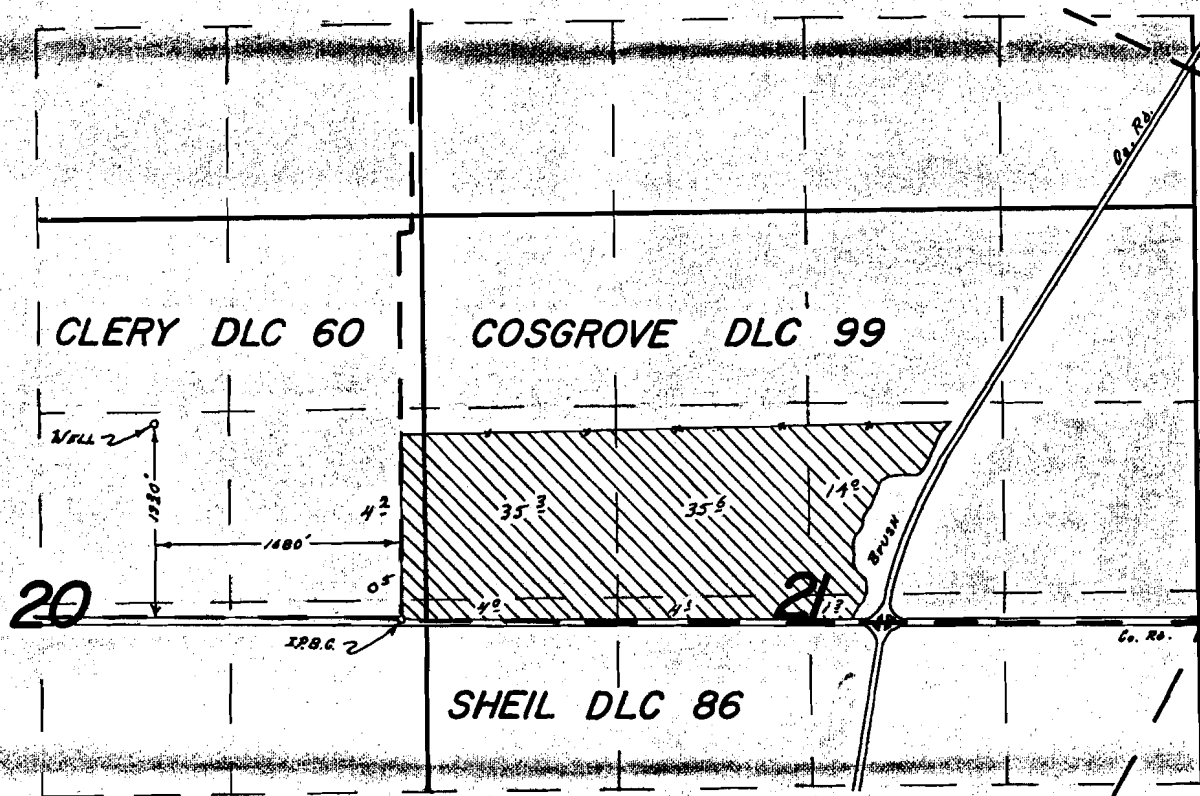

FINAL PROOF SURVEY
UNDER

Application No. B-4786 Permit No. B-4512
IN NAME OF

ELMER GOODING

Surveyed May 15 1973, by R. G. MUCKATY

CLERY D.L.C. 60

17 16

20 21

D.L.C. 69

BROWN

OWELL

19

23 5

33 2

34 5

39 5

33 0

3 13

2 5

16

4.6

4.7

0.3

0.3

1680 ft.

Surveyed April 11, 1967, by W.J. Rupprecht.