


# T. 38S. R. 11E. W. M.

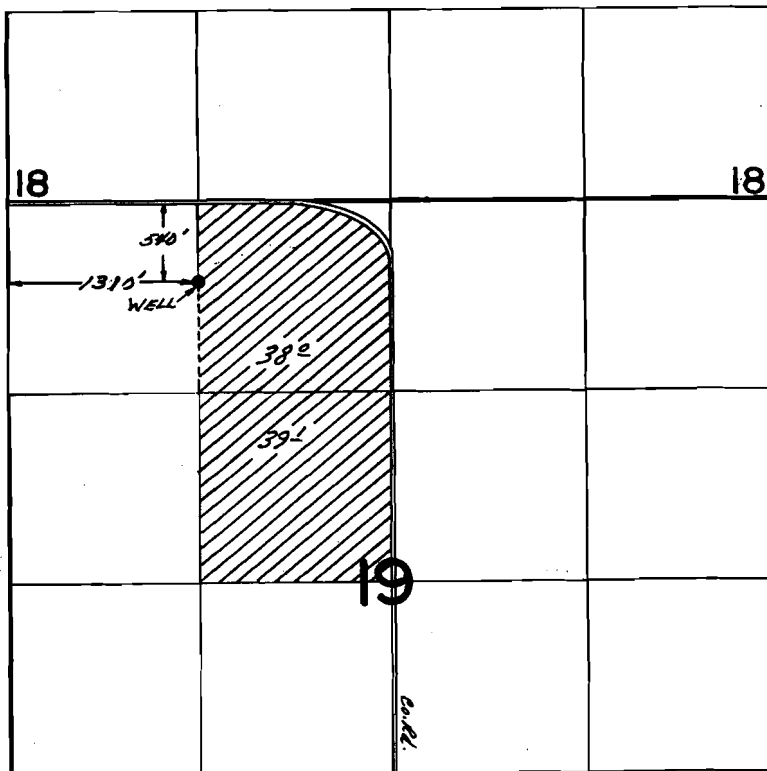


## FINAL PROOF SURVEY UNDER

Application No. G-7289 Permit No. G-6664...  
IN NAME OF

**HORSEFLY IRRIGATION DISTRICT**

Surveyed Sept. 24 1979., by C.R. RODRIGUEZ..