


T.11S., R.4W., W.M.

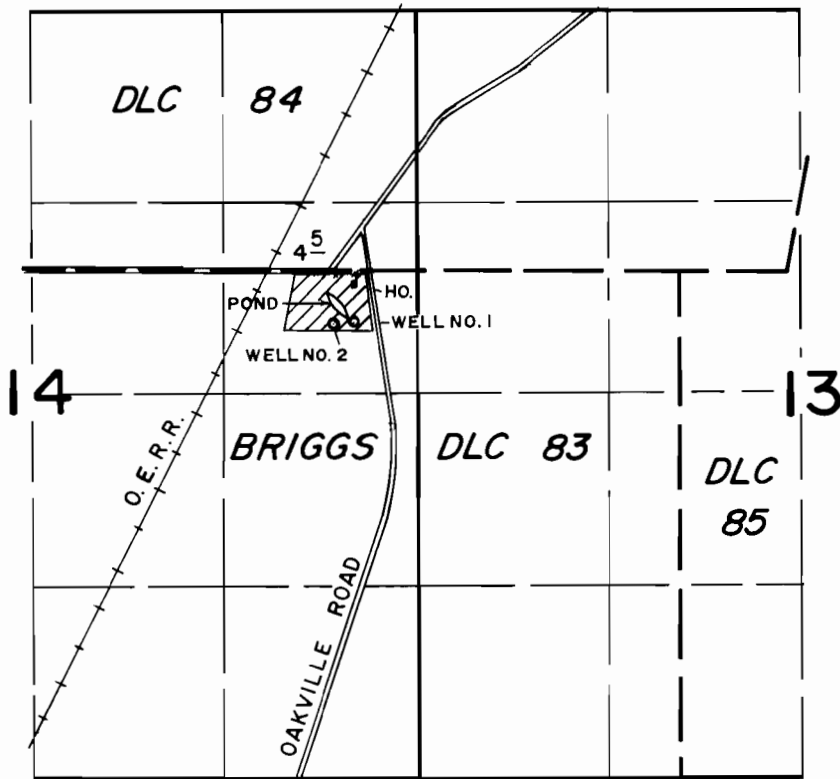

WELLS LOC. #1- 490'N. & 430'W.; #2- 470'N. & 570'W. BOTH FROM E.1/4 COR. SEC. 14.

FINAL PROOF SURVEY UNDER

Application No. G-7388 Permit No. G-6902....
IN NAME OF

L. E. GARRISON

Surveyed JULY 28, 1982, by L. M. TOLL