


G-6914
57273

T. 36S. R. 11E. W.M.

C Buck Co. v. Hanna Valley School

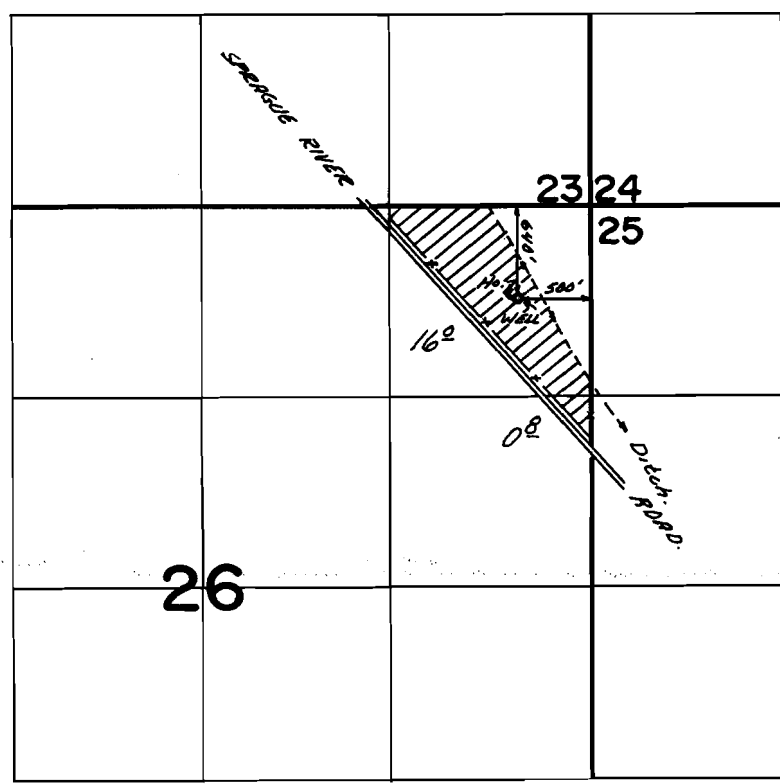

FINAL PROOF SURVEY UNDER

Application No. G-7410. Permit No. G-6914.
IN NAME OF

STEPHEN THOMAS HARRIS

Surveyed Sept. 23, 1979, by C.R. RODRIGUEZ