


G-6935
57274

T. 2S., R. 26E., W. M.

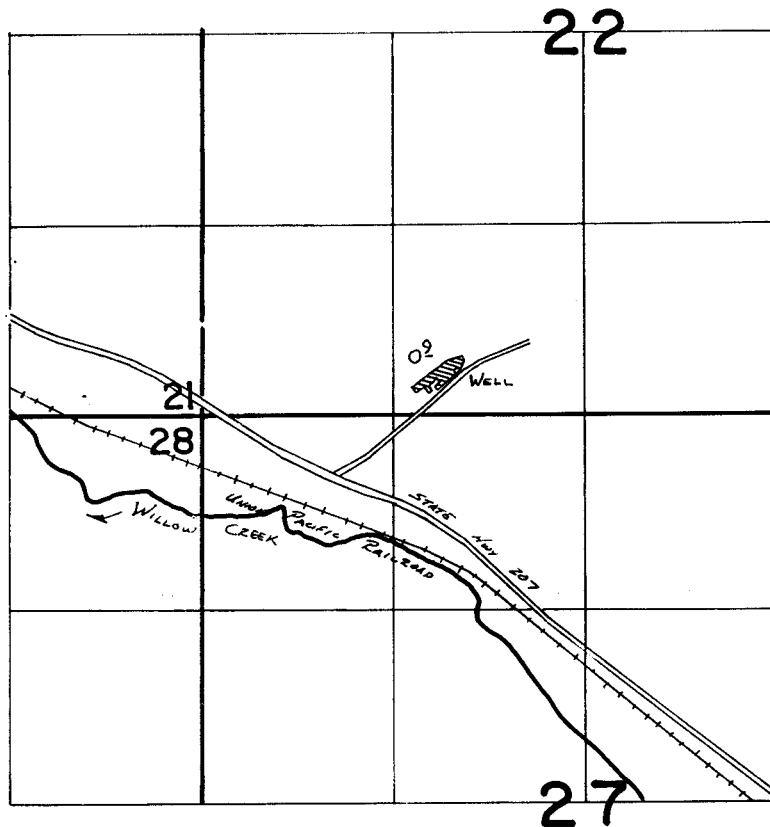

WELL LOCATED 300' N & 870' W. FROM S $\frac{1}{4}$ COR. SEC. 22

SCALE: 1" = 1320'

FINAL PROOF SURVEY UNDER

Application No. G:7439 Permit No. G:6935..
IN NAME OF

.....WESLEY MARLATT.....

Surveyed 4.25..... 19.84., by Y. L. Church.....