


T. 36 S., R. 1 E., W. M.

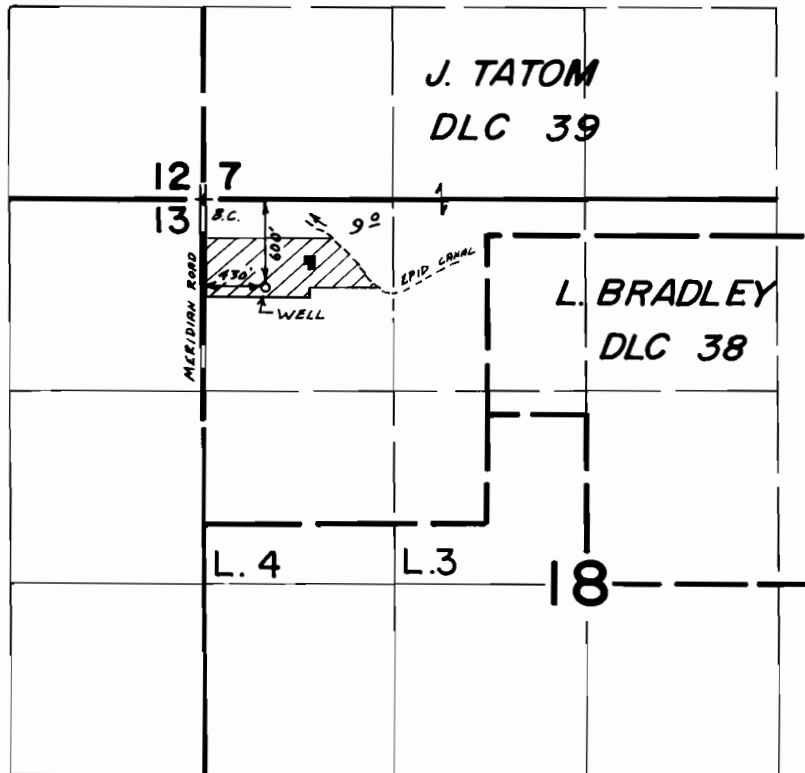

Scale 1" = 1320'

FINAL PROOF SURVEY
UNDER

Application No. G-7519. Permit No. G-6993...
IN NAME OF

DEANE & ELLEN L. OWENS

Surveyed JUNE 13 19.84, by B.S. JAMES