


T.1N., R.12 E., W.M.

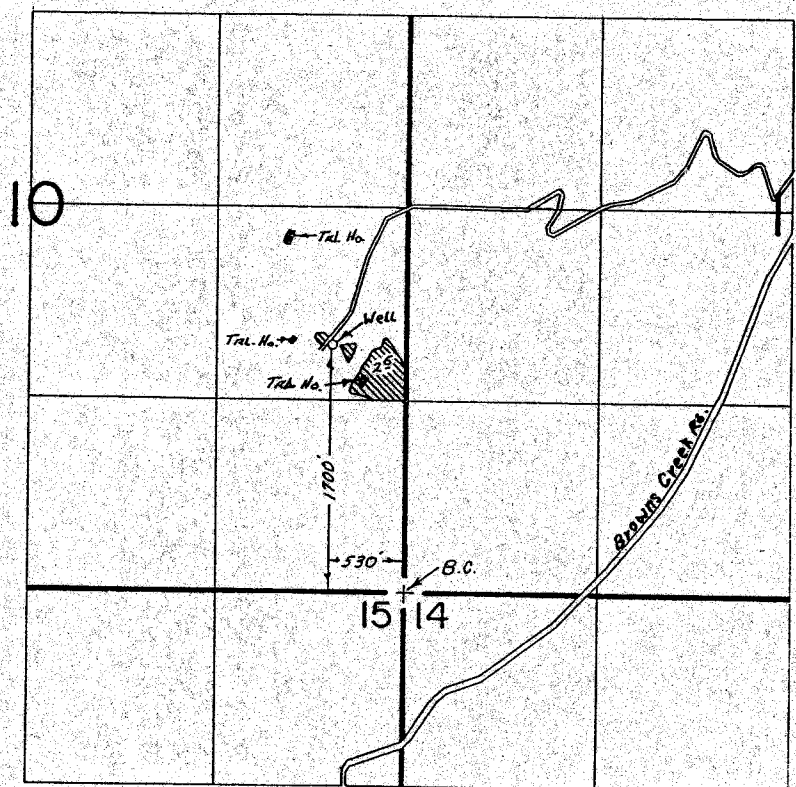

**FINAL PROOF SURVEY**  
UNDER

Application No. G-7974. Permit No. G-7404.  
IN NAME OF

STANLEY D. COLE & MARJORIE J. COLE

Surveyed Jan. 10, 1983, by T. J. Paul